
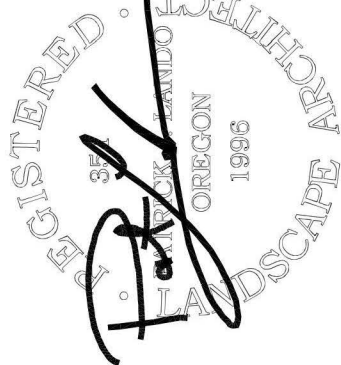


DRAWING: \$FILE\$ PLOTTED ON: \$DATE\$ PLOTTED BY: \$USERNAME\$ PLOTTED FROM: \$COMPUTERNAME\$

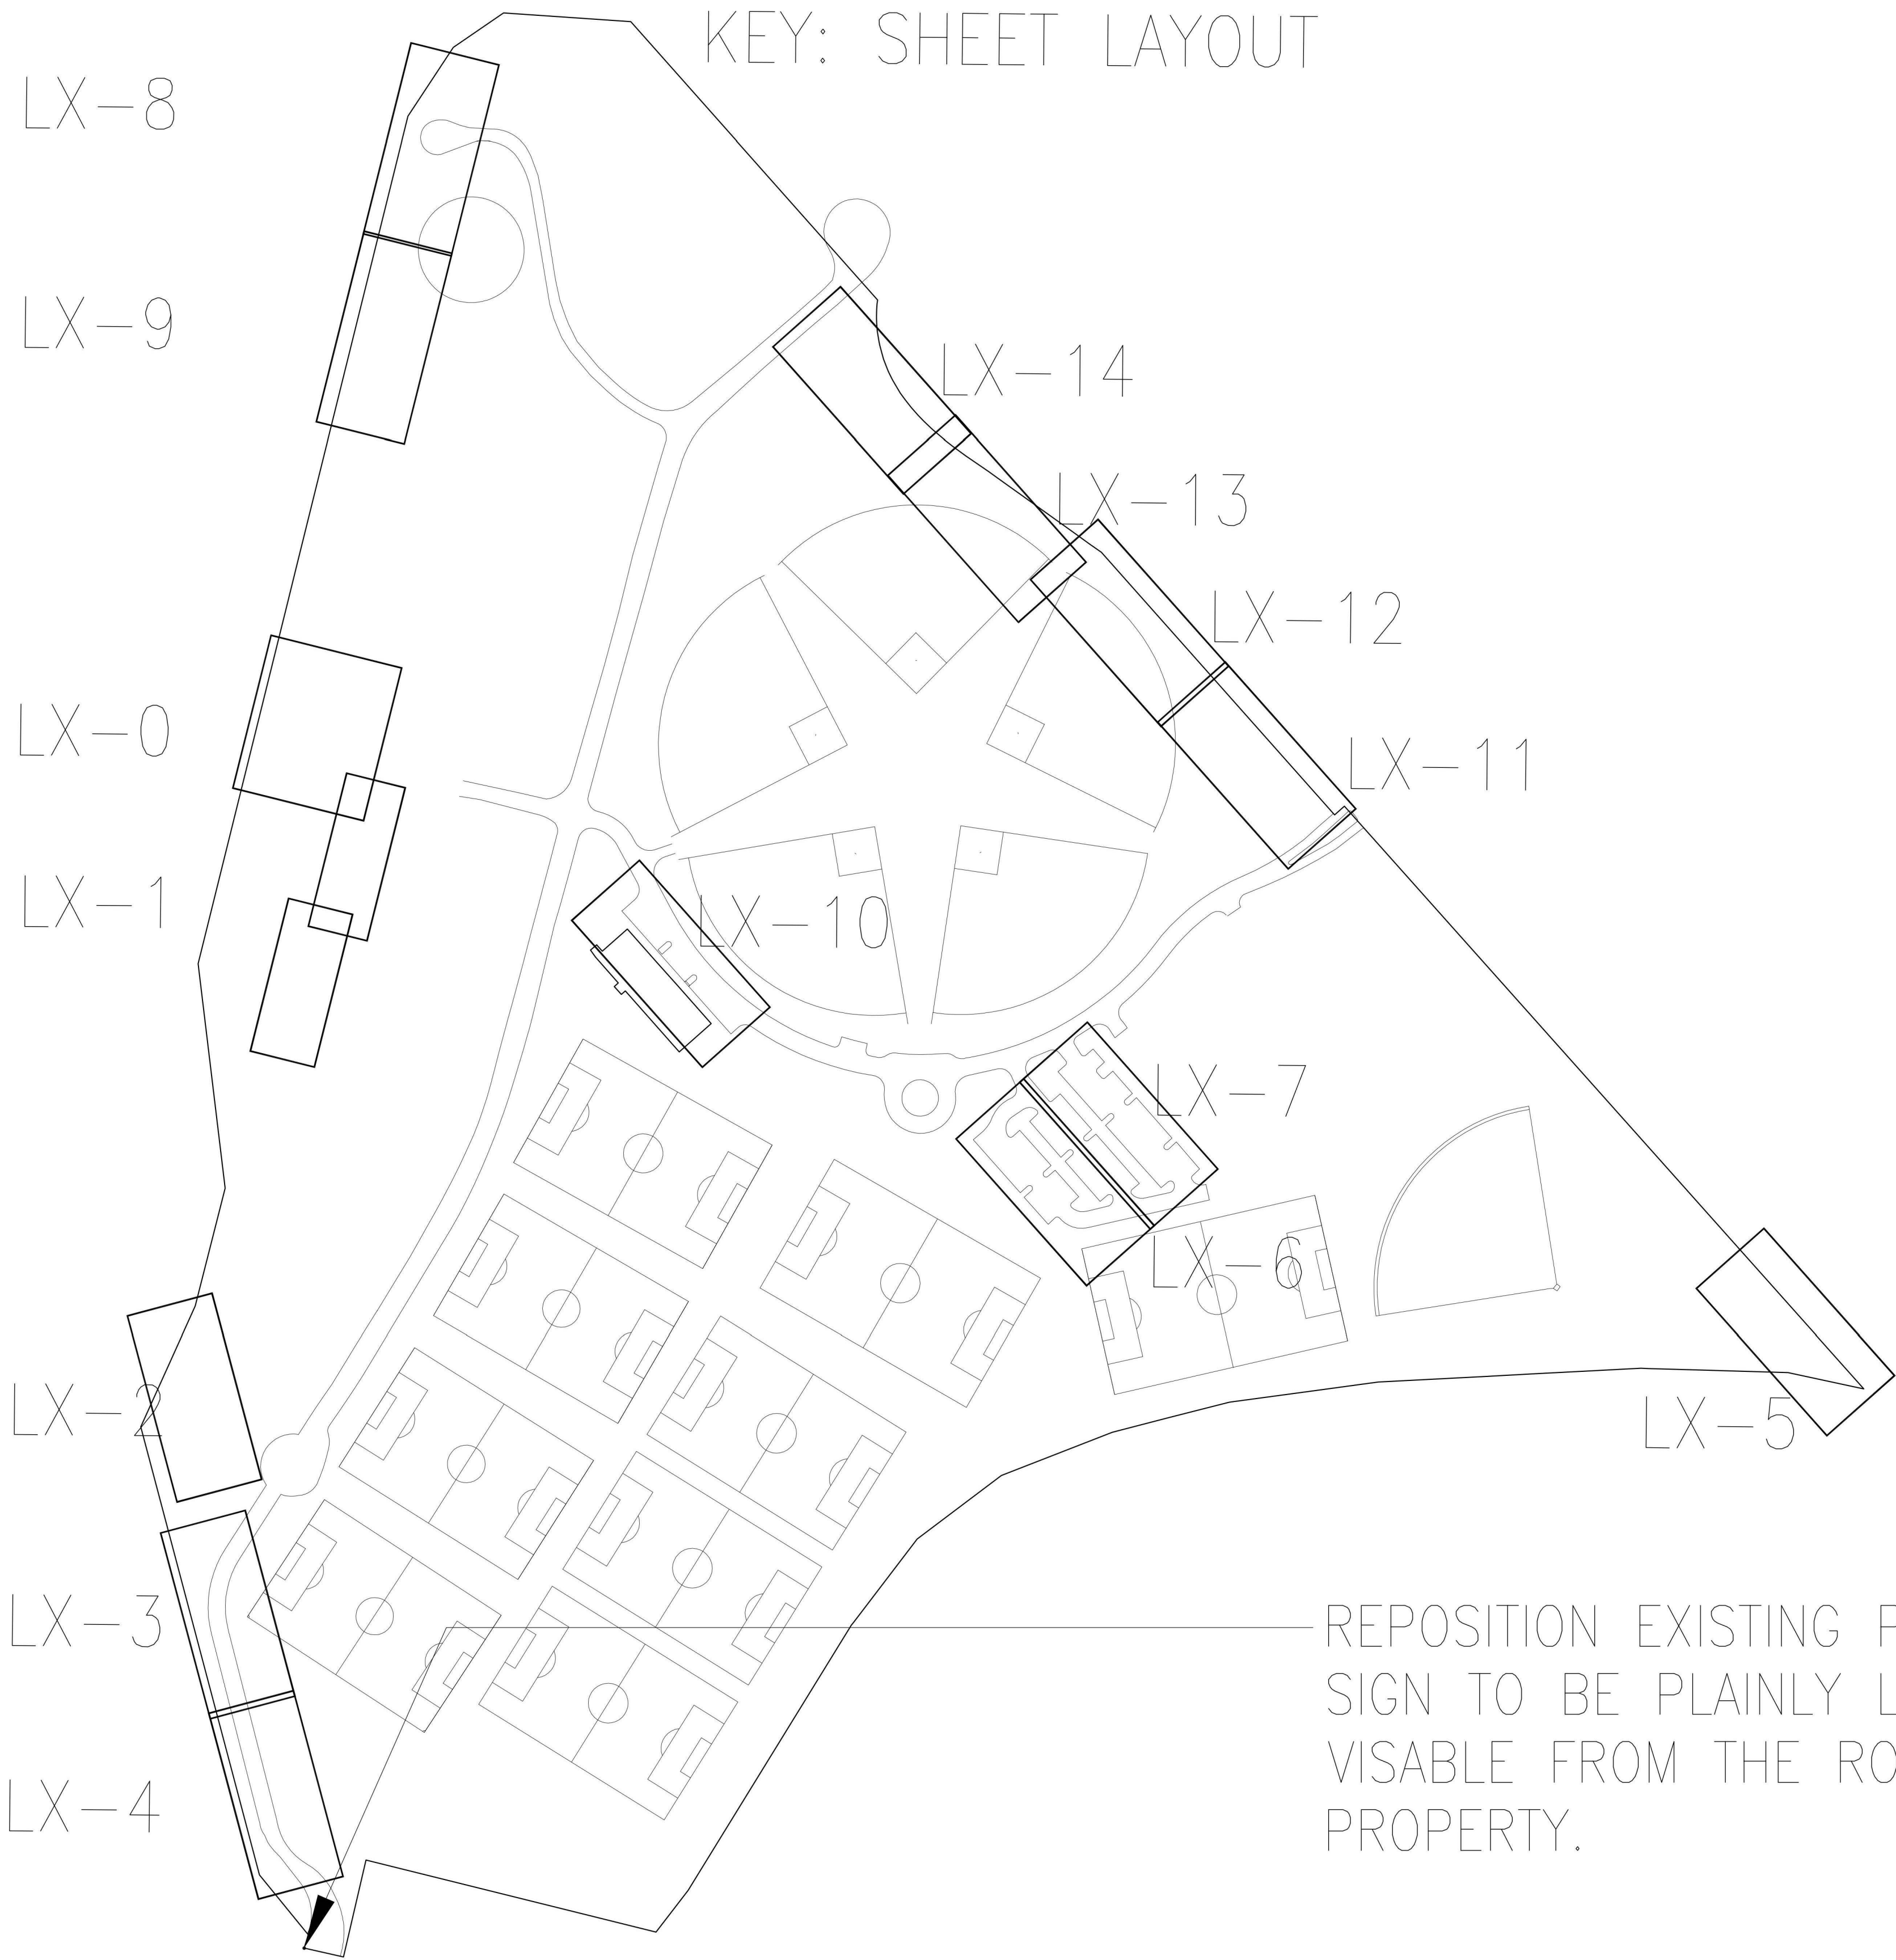

Portland Parks and Recreation
Ananda Fritz, Commissioner Kira Selley, Intern Director

Landscape Sheet Key Plan
Urban Forestry Maintenance Facility
10910 N Denver, Portland, OR 97217
PROJECT MANAGER: ROBIN LAUGHLIN

DATE: 10.04.2019 SCALE: DRAWN BY: PL SECTION:

REVISIONS

DATE	DESCRIPTION	BY



L0-00
Job No.
4655-01




PLOTTED FROM: \$COMPUTERNAME\$

PLOTTED BY: \$USERNAME\$

PLOTTED ON: \$DATE\$


DRAWING: \$FILE\$

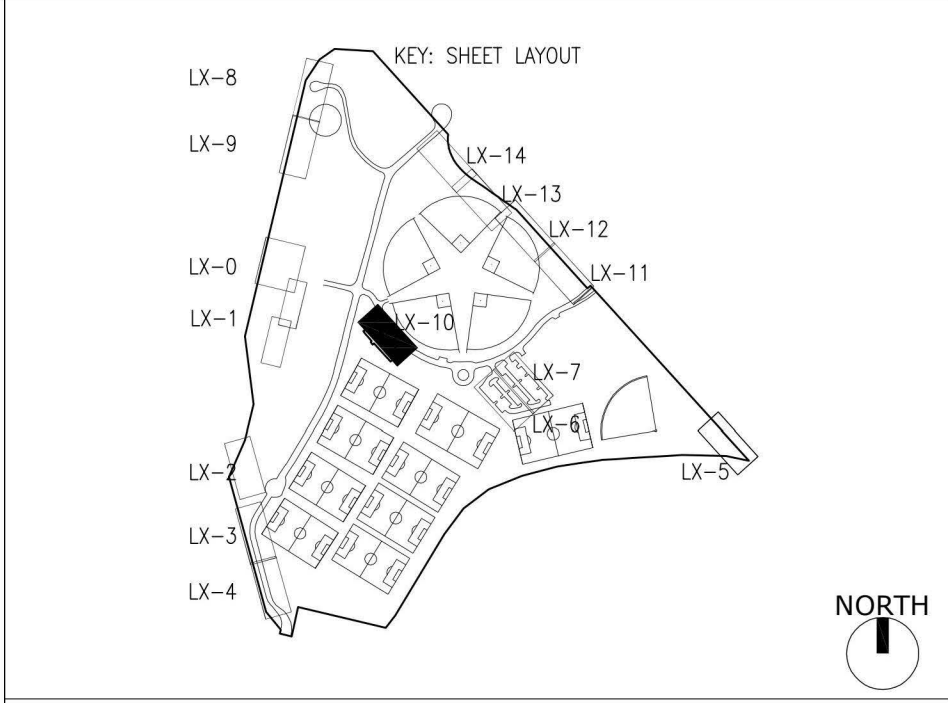

TREE PROTECTION NOTES:

- 1.) PROTECT ALL TREES AND SHRUBS INDICATED TO REMAIN.
- 2.) WRITTEN DIMENSIONS TAKE PRECEDENCE OVER SCALED DIMENSIONS.
- 3.) OBTAIN ACCEPTANCE OF HORIZONTAL ALIGNMENT OF ELEMENTS IN THE FIELD PRIOR TO INSTALLATION.

LEGEND

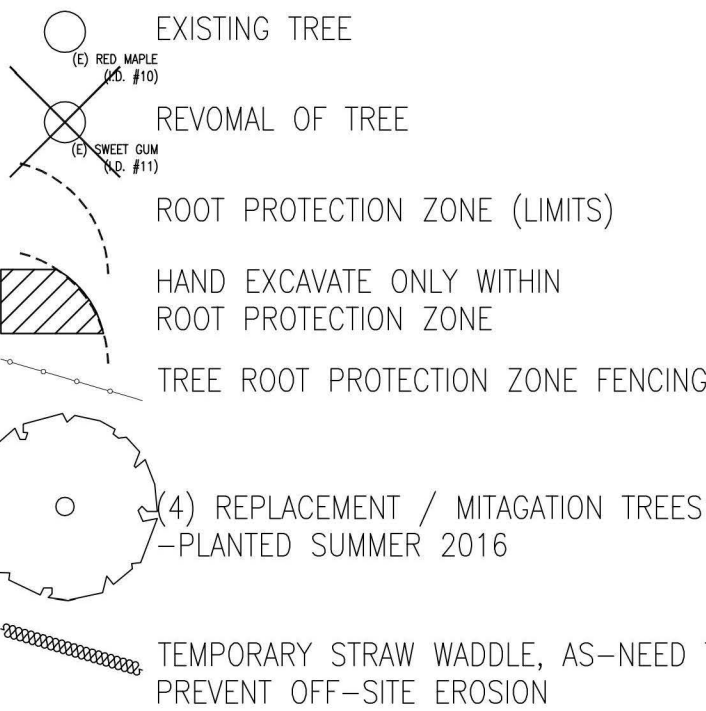


TREE REMOVAL CHART			
I.D.	SIZE	SPECIES	MITAGATED / EXEMPT
00004	44"	POPULAR	EXEMPT (POOR HEALTH)

NOTES:

LAYOUT NOTES


- 1.) THIS LAYOUT PLAN IS BASED ON THE SITE SURVEY INFORMATION AND EXISTING CONDITIONS PLAN PROVIDED BY THE ARCHITECT AND CIVIL ENGINEER. THE CONTRACTOR IS TO VERIFY ALL EXISTING CONDITIONS PRIOR TO CONSTRUCTION. NOTIFY THE LANDSCAPE ARCHITECT OF ANY DISCREPANCIES FOUND.
- 2.) PROTECT ALL TREES AND SHRUBS INDICATED TO REMAIN.
- 3.) WRITTEN DIMENSIONS TAKE PRECEDENCE OVER SCALED DIMENSIONS.
- 4.) OBTAIN ACCEPTANCE OF LAYOUT (HORIZONTAL ALIGNMENT) OF ELEMENTS IN THE FIELD PRIOR TO INSTALLATION.
- 5.) CONCRETE AND CONCRETE UNIT PAVING PATTERNS ARE NOT SHOWN ON THIS SHEET FOR CLARITY.
- 6.) ROUGH AND FINE GRADING SHALL BE REVIEWED AND APPROVED BY LANDSCAPE ARCHITECT PRIOR TO PLANTING.
- 7.) SET STRAIGHT GRADES BETWEEN ELEVATIONS UNLESS OTHERWISE NOTED.
- 8.) VERIFY AND ENSURE POSITIVE DRAINAGE AWAY FROM BUILDING AT 0.01 SLOPE MINIMUM.
- 9.) MATCH EXISTING ELEVATIONS WHERE NEW PAVING ABUTS EXISTING PAVING.
- 10.) PROTECT EXISTING UTILITIES, SEE GENERAL NOTES.
- 11.) PROVIDE CROSS SLOPE OF 1% MINIMUM ON ALL CONCRETE PATHS.
- 12.) MAXIMUM PAVING SLOPE IS 2.0% UNLESS NOTED

MATERIALS LEGEND:

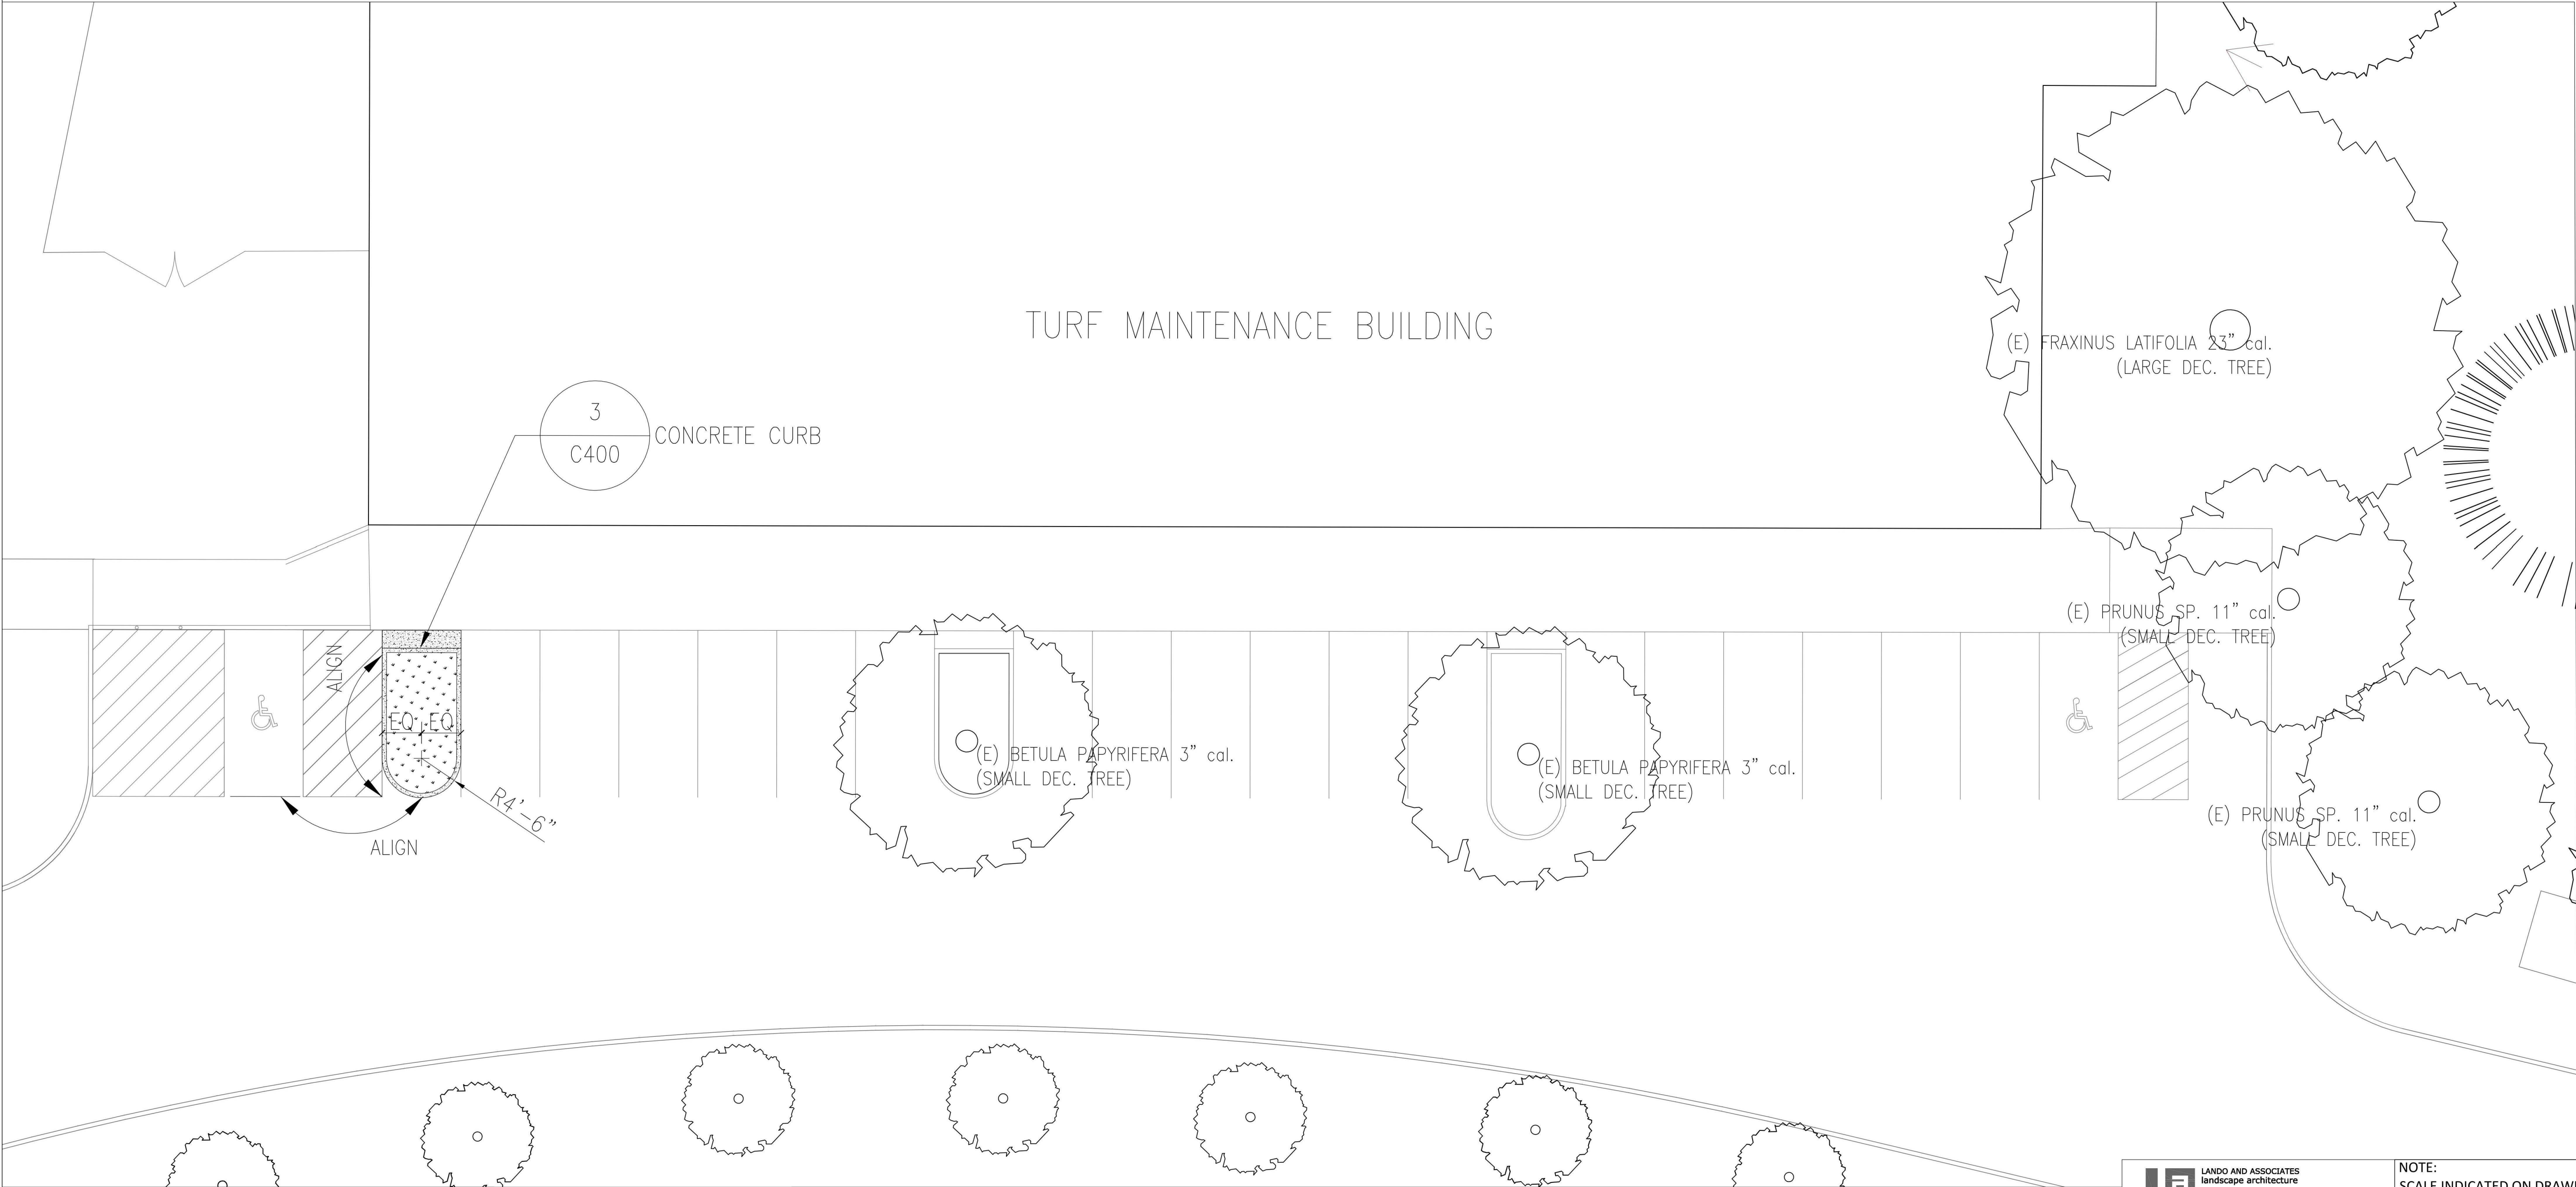

1 LANDSCAPE LAYOUT

SCALE: 1" = 10' - 0"

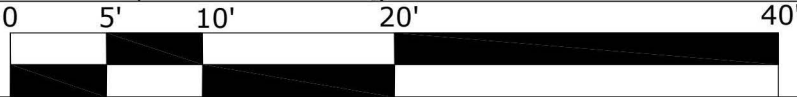


NOTE:
SCALE INDICATED ON DRAWING
IS CORRECT IF DRAWING
BORDER IS 22" X 34".



opsis

503.525.9511
www.opsisearch.com
920 NORTHWEST SEVENTEENTH AVENUE
PORTLAND | OREGON | 97209
copyright 2016 opsis architecture llp
ALL RIGHTS RESERVED

PERMIT / BID SET
08.30.2018

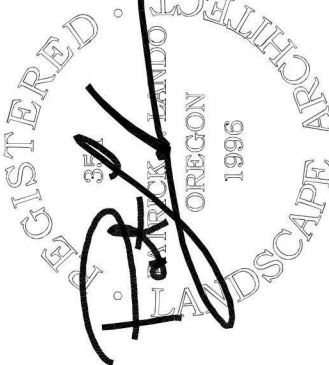

Portland Parks and Recreation

Ananda Fritz, Commissioner Kira Selley, Intern Director

Landscape Layout & Materials Plan
Urban Forestry Maintenance Facility

PROJECT MANAGER: ROBIN LAUGHLIN

DATE: 10.04.2019

SCALE:

DRAWN BY: PL

SECTION:

REVISIONS

DATE	DESCRIPTION	BY



L1-10







Job No.
4655-01

PLOTTED FROM: \$COMPUTERNAME\$

PLOTTED BY: \$USERNAME\$


PLOTTED ON: \$DATE\$

DRAWING: \$FILE\$

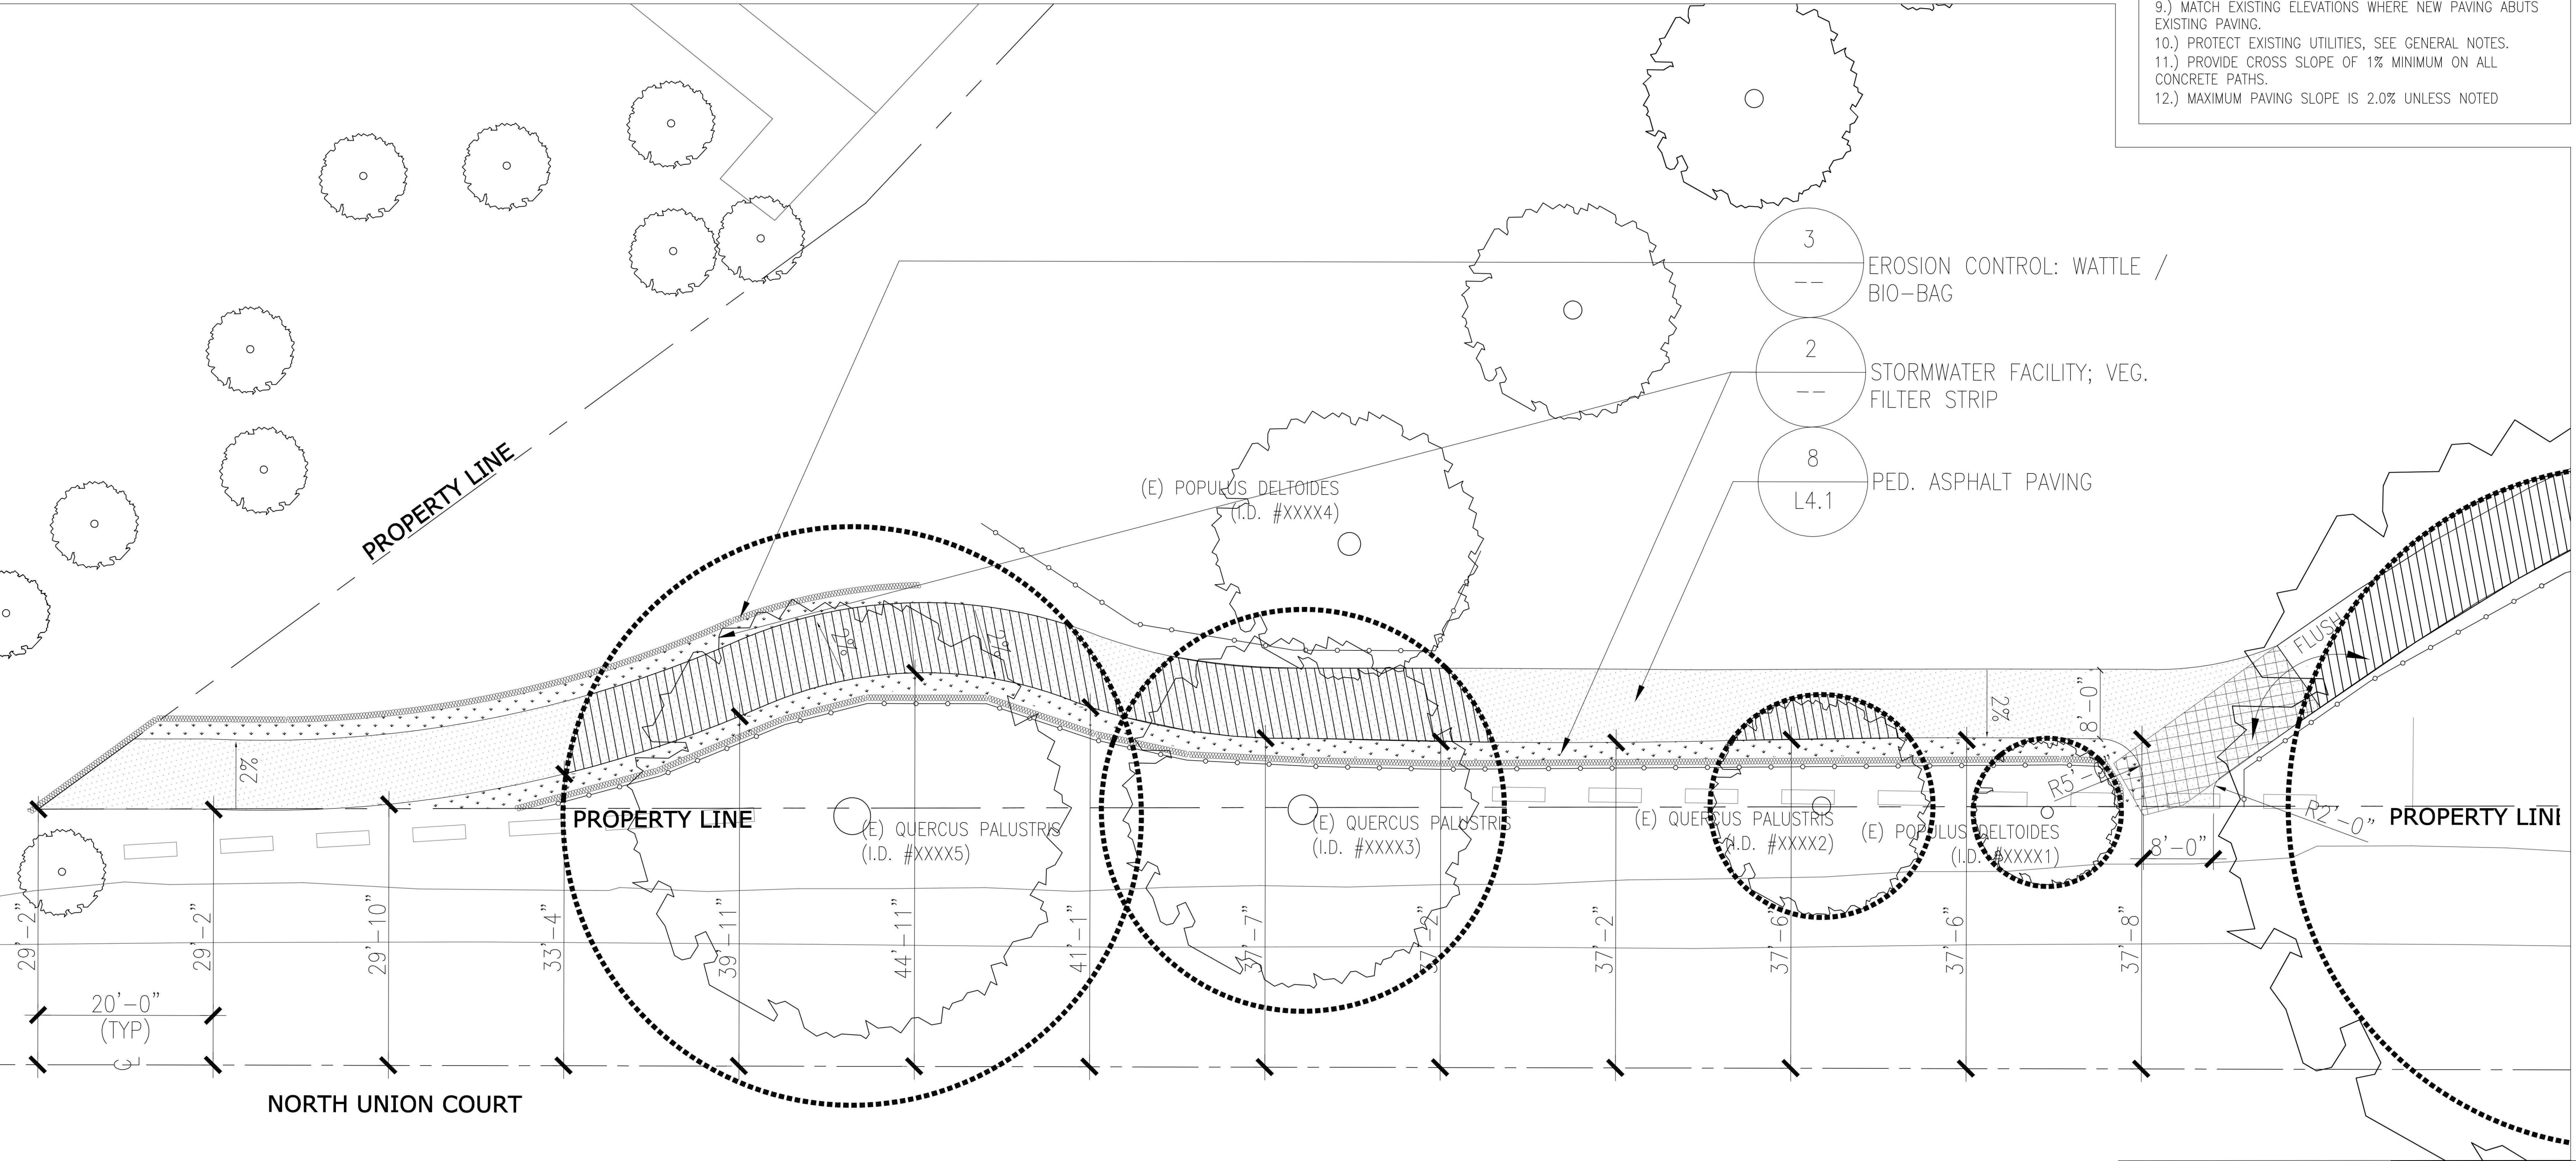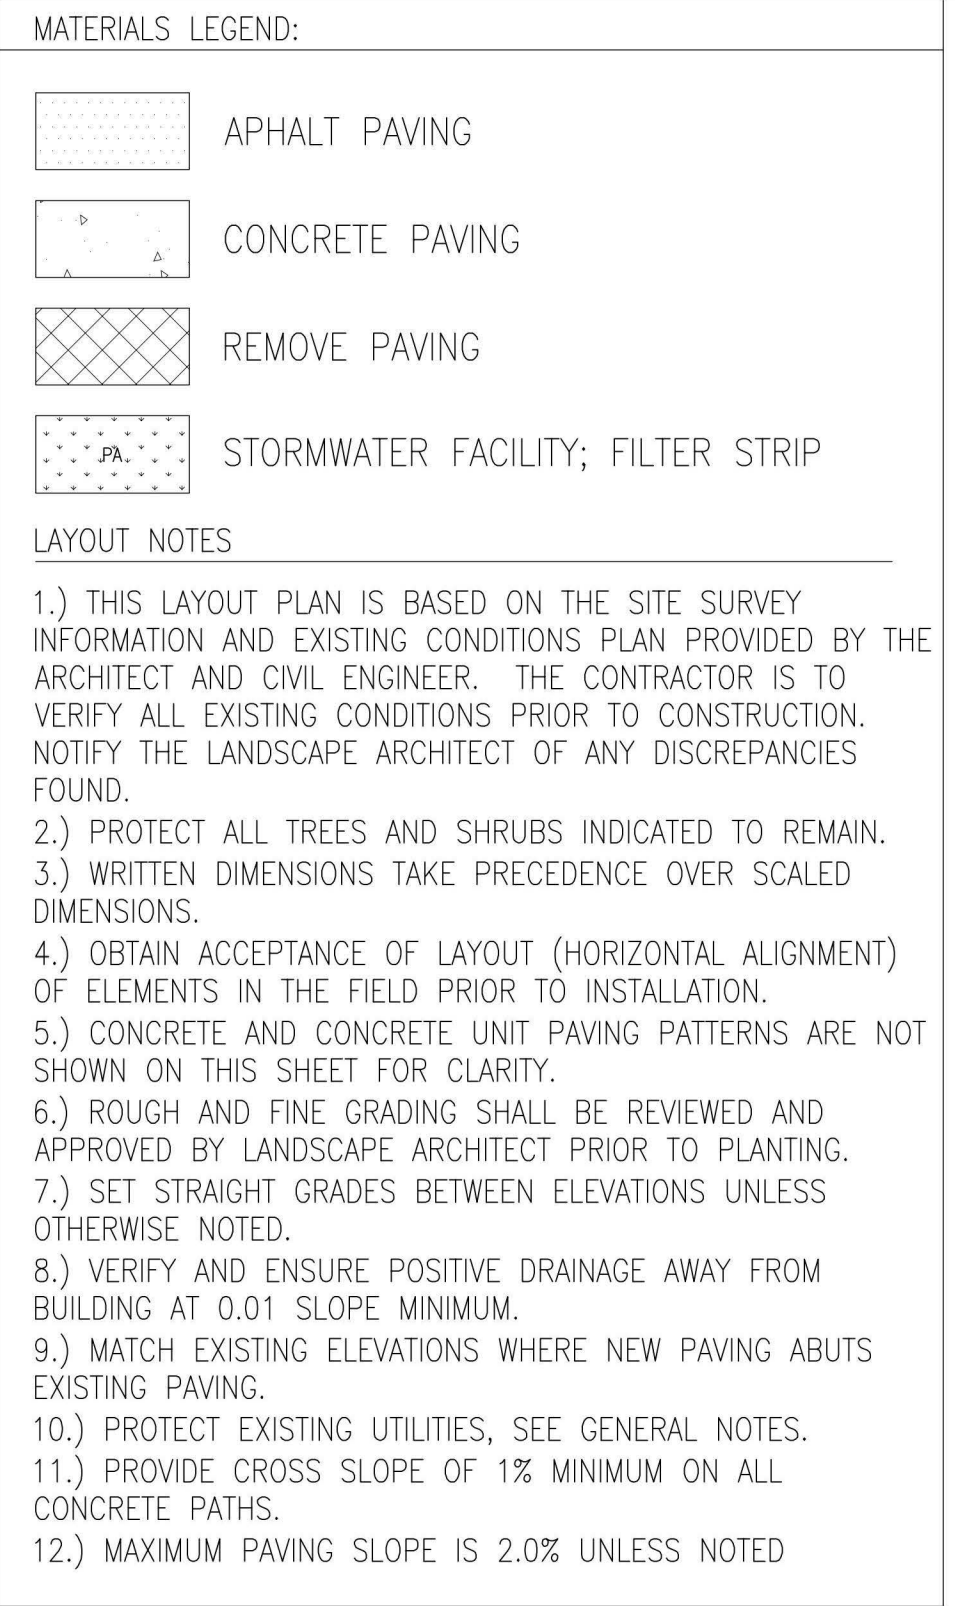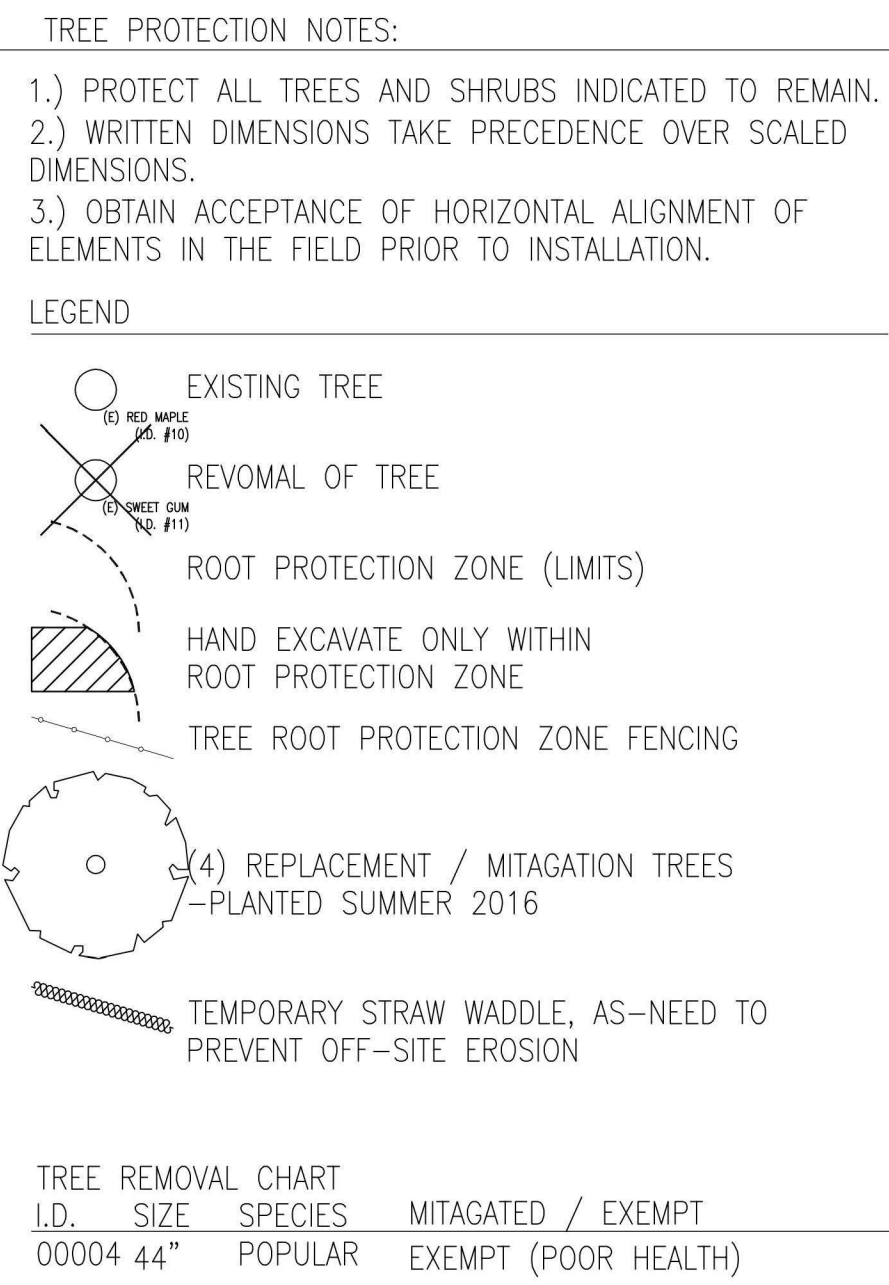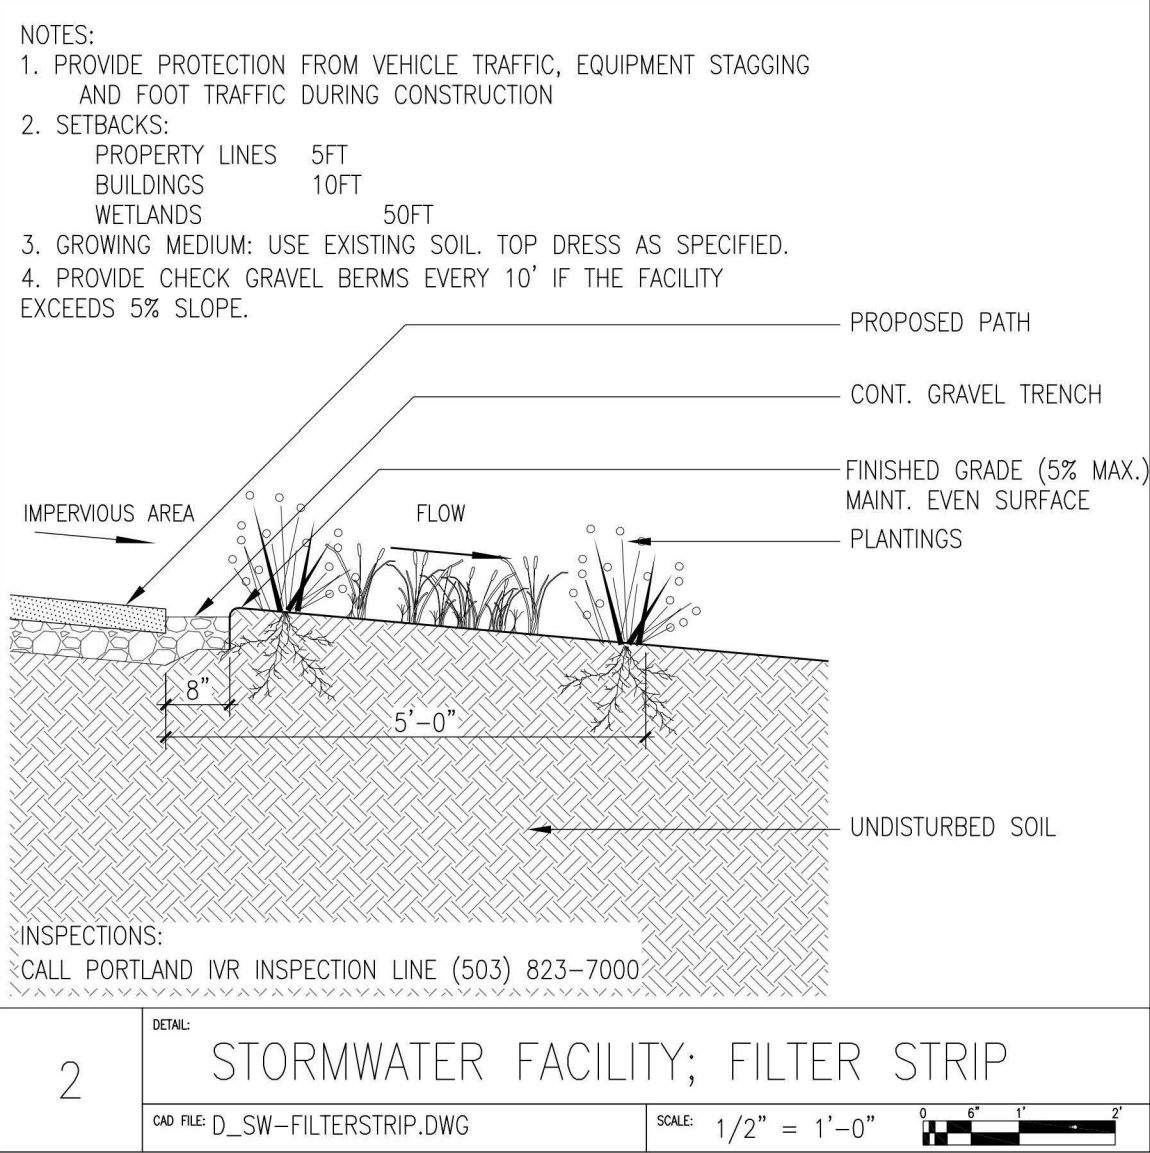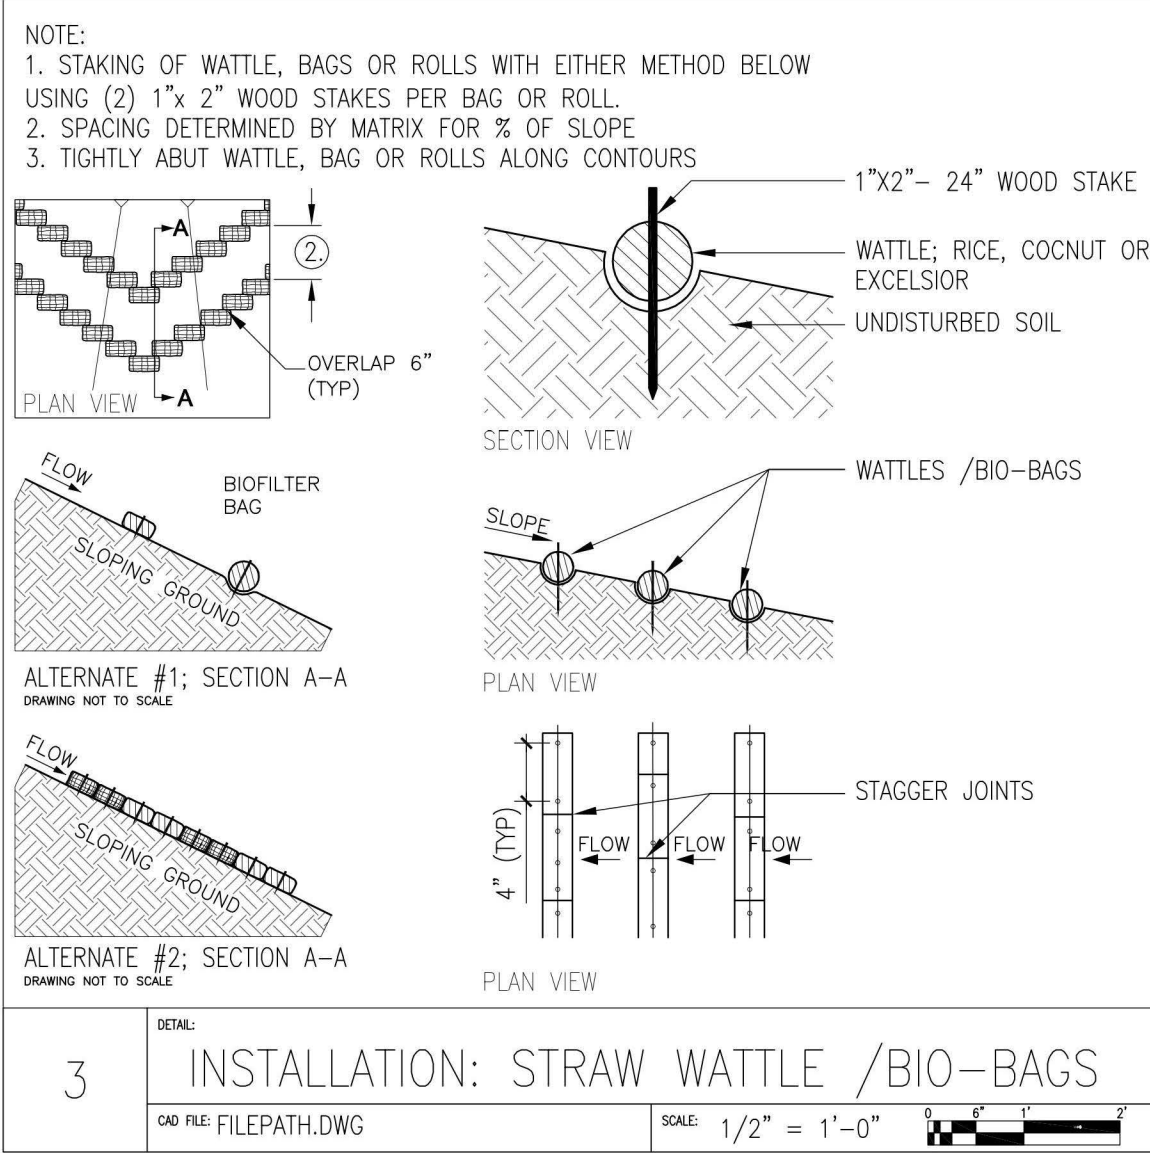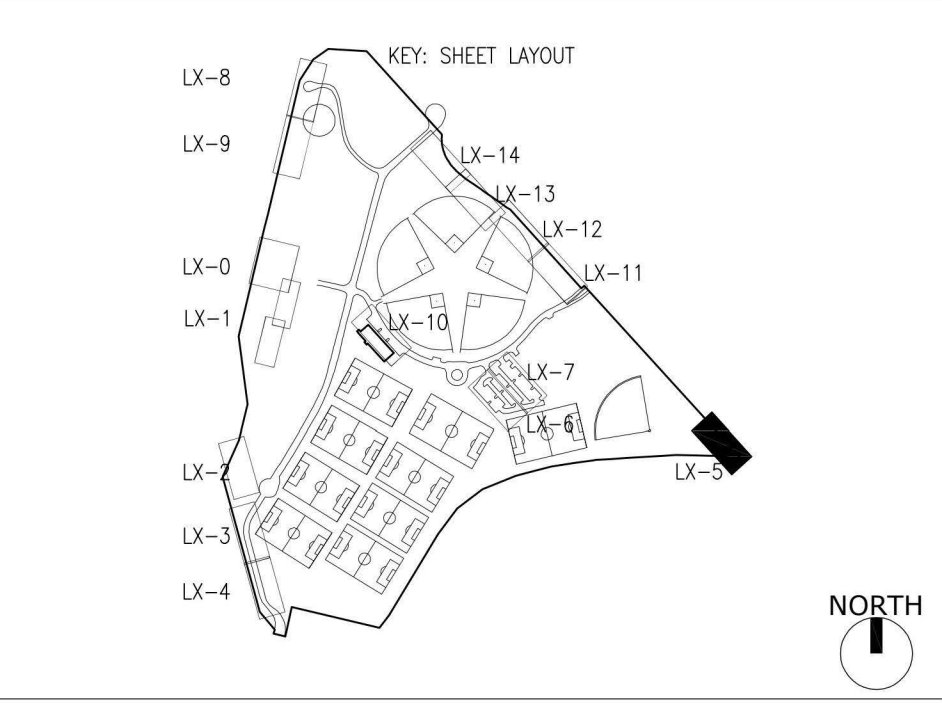

1 LANDSCAPE LAYOUT

SCALE: 1" = 10' - 0"

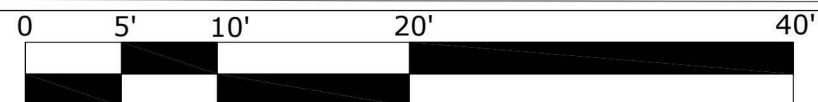

LANDO AND ASSOCIATES
LANDSCAPE ARCHITECTURE
5607 SE SCOTT DRIVE
PORTLAND | OREGON | 97215
503.233.6600 | Lando_LandscapeArchitecture.com


NOTE:
SCALE INDICATED ON DRAWING
IS CORRECT IF DRAWING
BORDER IS 22" X 34".

PORTLAND
PARKS & RECREATION
Healthy Parks, Healthy Portland

opsis

503.525.9511
www.opsisearch.com
920 NORTHWEST SEVENTEENTH AVENUE
PORTLAND | OREGON | 97209
copyright 2016 opsis architecture llp
ALL RIGHTS RESERVED

PERMIT / BID SET
08.30.2018

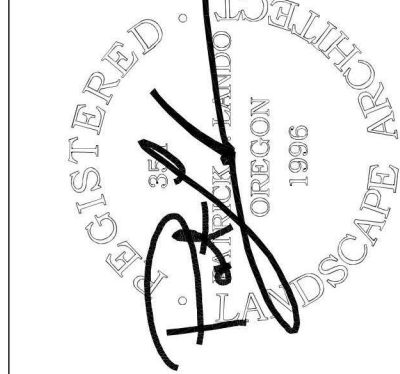

Portland Parks and Recreation
Ananda Fritz, Commissioner Kira Selley, Intern Director

Landscape Layout & Materials Plan
Urban Forestry Maintenance Facility
PROJECT MANAGER: ROBIN LAUGHLIN
10910 N Denver, Portland, OR 97217

DATE: 10.04.2019 SCALE: DRAWN BY: PL SECTION:

REVISIONS

DATE	DESCRIPTION	BY

PARKS
REPLACEMENT
BOND
2014

L1-5

Job No.
4655-01

NOTES:

IRRIGATION NOTES

1.) INSTALL IRRIGATION SYSTEM IN ACCORDANCE WITH ALL LOCAL CODES AND REGULATIONS.

2.) IRRIGATION PLANS ARE DIAGRAMMATIC. ALL IRRIGATION EQUIPMENT SHALL BE PLACED IN PLANTED AREAS WHENEVER POSSIBLE. FIELD ADJUST LINES TO AVOID CONFLICT WITH UTILITIES AND EXISTING CONDITIONS.

3.) SYSTEM IS DESIGNED TO OPERATE WITH STATIC PRESSURE BETWEEN 50 AND 70 PSI WITH A MINIMUM 30 GPM AT POINT OF CONNECTION.

4.) HEAD LAYOUT AND ZONES ARE BASED ON THE DATA AS SHOWN IN IRRIGATION LEGEND. CONTRACTOR SHALL VERIFY GPM AND PSI AT POC PRIOR TO STARTING WORK. NOTIFY LANDSCAPE ARCHITECT IMMEDIATELY IF ACTUAL FIELD DATA DIFFERS FROM THIS INFORMATION.

5.) IRRIGATION LATERALS ARE SIZED STARTING AT VALVE AND CONTINUING IN DIRECTION OF FLOW. REDUCTIONS IN PIPE SIZE ARE LABELED BEGINNING DOWNSTREAM OF NEAREST FITTING. ALL LATERALS NOT SIZED ARE MINIMUM 3/4" OR SAME SIZE AT NEAREST ADJACENT PIPE.

6.) CONTRACTOR SHALL FIELD MARK LAYOUT OF TRENCHES AND VALVE LOCATIONS FOR REVIEW BY LANDSCAPE ARCHITECT PRIOR TO CONSTRUCTION.

7.) EXCEPT WHERE SLEEVES ARE SHOWN, MAINLINE IS SHOWN BENEATH PAVING SURFACES FOR GRAPHIC CLARITY ONLY. ACTUAL LOCATION IS IN P.A., UNLESS OTHERWISE NOTED.

8.) LANDSCAPE CONTRACTOR IS RESPONSIBLE FOR ALL SLEEVING UNDER ALL HARDSCAPE SURFACES. CONTRACTOR SHALL VERIFY WITH LANDSCAPE ARCHITECT ALL SLEEVE LOCATIONS, QUANTITIES AND SIZES TO ACCOMMODATE ALL IRRIGATION PIPING SHOWN.

9.) CONTRACTOR SHALL COORDINATE IRRIGATION POINT OF CONNECTION AND LOCATION OF AUTOMATIC CONTROLLER. COORDINATE ALL WORK WITH OTHER TRADES INVOLVED.

10.) ALL COMPONENTS OF IRRIGATION SYSTEM SHALL BE INSTALLED AND ADJUSTED TO PROVIDE ADEQUATE COVERAGE AND MINIMIZE OVERSPRAY ONTO BUILDINGS, WALKS AND ROADS.

11.) ALL VALVES SHALL BE LOCATED IN A MANNER THAT FACILITATES ACCESS FOR MAINTENANCE. SIZE BOXES TO ACCOMMODATE COMPLETE VALVE ASSEMBLY PER DETAILS. MAINTAIN 18" BETWEEN VALVE BOXES AND ADJACENT VALVES BOXES AND/OR PAVEMENT.

12.) ALL VALVE BOX COVERS SHALL BE BLACK, AND INSTALLED PERPENDICULAR TO WALKS, CURBS AND/OR WALLS.

13.) INSTALL TWO VALVES IN ONE VALVE BOX WHENEVER POSSIBLE, INSTALL "JUMBO BOX" WHEN TWO CONTROL VALVES ARE ADJACENT TO QUICK COUPLING VALVE.

14.) INSTALL IRRIGATION HEADS: PERPENDICULAR TO SLOPE OF FINISHED GRADES, FLUSH WITH ALL WALKS AND CURBS, AND 1" MIN. FROM ALL WALKS AND WALLS.

15.) CONTRACTOR SHALL PROVIDE, INSTALL AND MAKE POWER CONNECTIONS TO CONTROLLER TO ALLOW FOR COMPLETE WORKING SYSTEM.

16.) A WATER WINDOW TIME (12:00 A.M. TO 5:00 A.M.) WILL BE REQUIRED TO PROVIDE FOR ADEQUATE SOIL IRRIGATION DURING PEAK SUMMER TIME DEMAND.



17.) PERFORM PRESSURE TEST AND VERIFY PRESSURE AND FLOW RATES SHOWN AT POINTS OF CONNECTION. NOTIFY LANDSCAPE ARCHITECT OF ANY DISCREPANCIES PRIOR TO BEGINNING CONSTRUCTION.

18.) SLEEVING IS REQUIRED FOR ALL IRRIGATION AND CONTROL WIRE UNDER ALL PAVEMENTS, WALLS, ETC. CONTRACTOR IS RESPONSIBLE FOR VERIFICATION OF SIZE OF ALL SLEEVING REQUIRED FOR COMPLETE INSTALLATION OF WORK. SLEEVING SHALL BE PVC SCHEDULE 40 PIPE

19.) MAINLINE SHOWN RUNNING PARALLEL TO PAVING EDGE SHALL BE INSTALLED IN ADJACENT PLANTING AREAS AND NOT UNDER PAVEMENT.

20.) VERIFY SITE DIMENSIONS AND EXISTING CONDITIONS INCLUDING LOCATIONS OF UNDERGROUND UTILITIES SUCH AS GAS LINE AND WATER LINES PRIOR TO BEGINNING WORK. CONTRACTOR IS RESPONSIBLE FOR PROTECTION OF EXISTING CONDITIONS TO REMAIN AND REPAIR OR REPLACEMENT OF ANY SITE DAMAGES.

21.) IRRIGATION PLAN IS DIAGRAMMATIC. PLACE VALVE BOXES/POC AT LOCATIONS APPROVED IN FIELD BY OWNER.

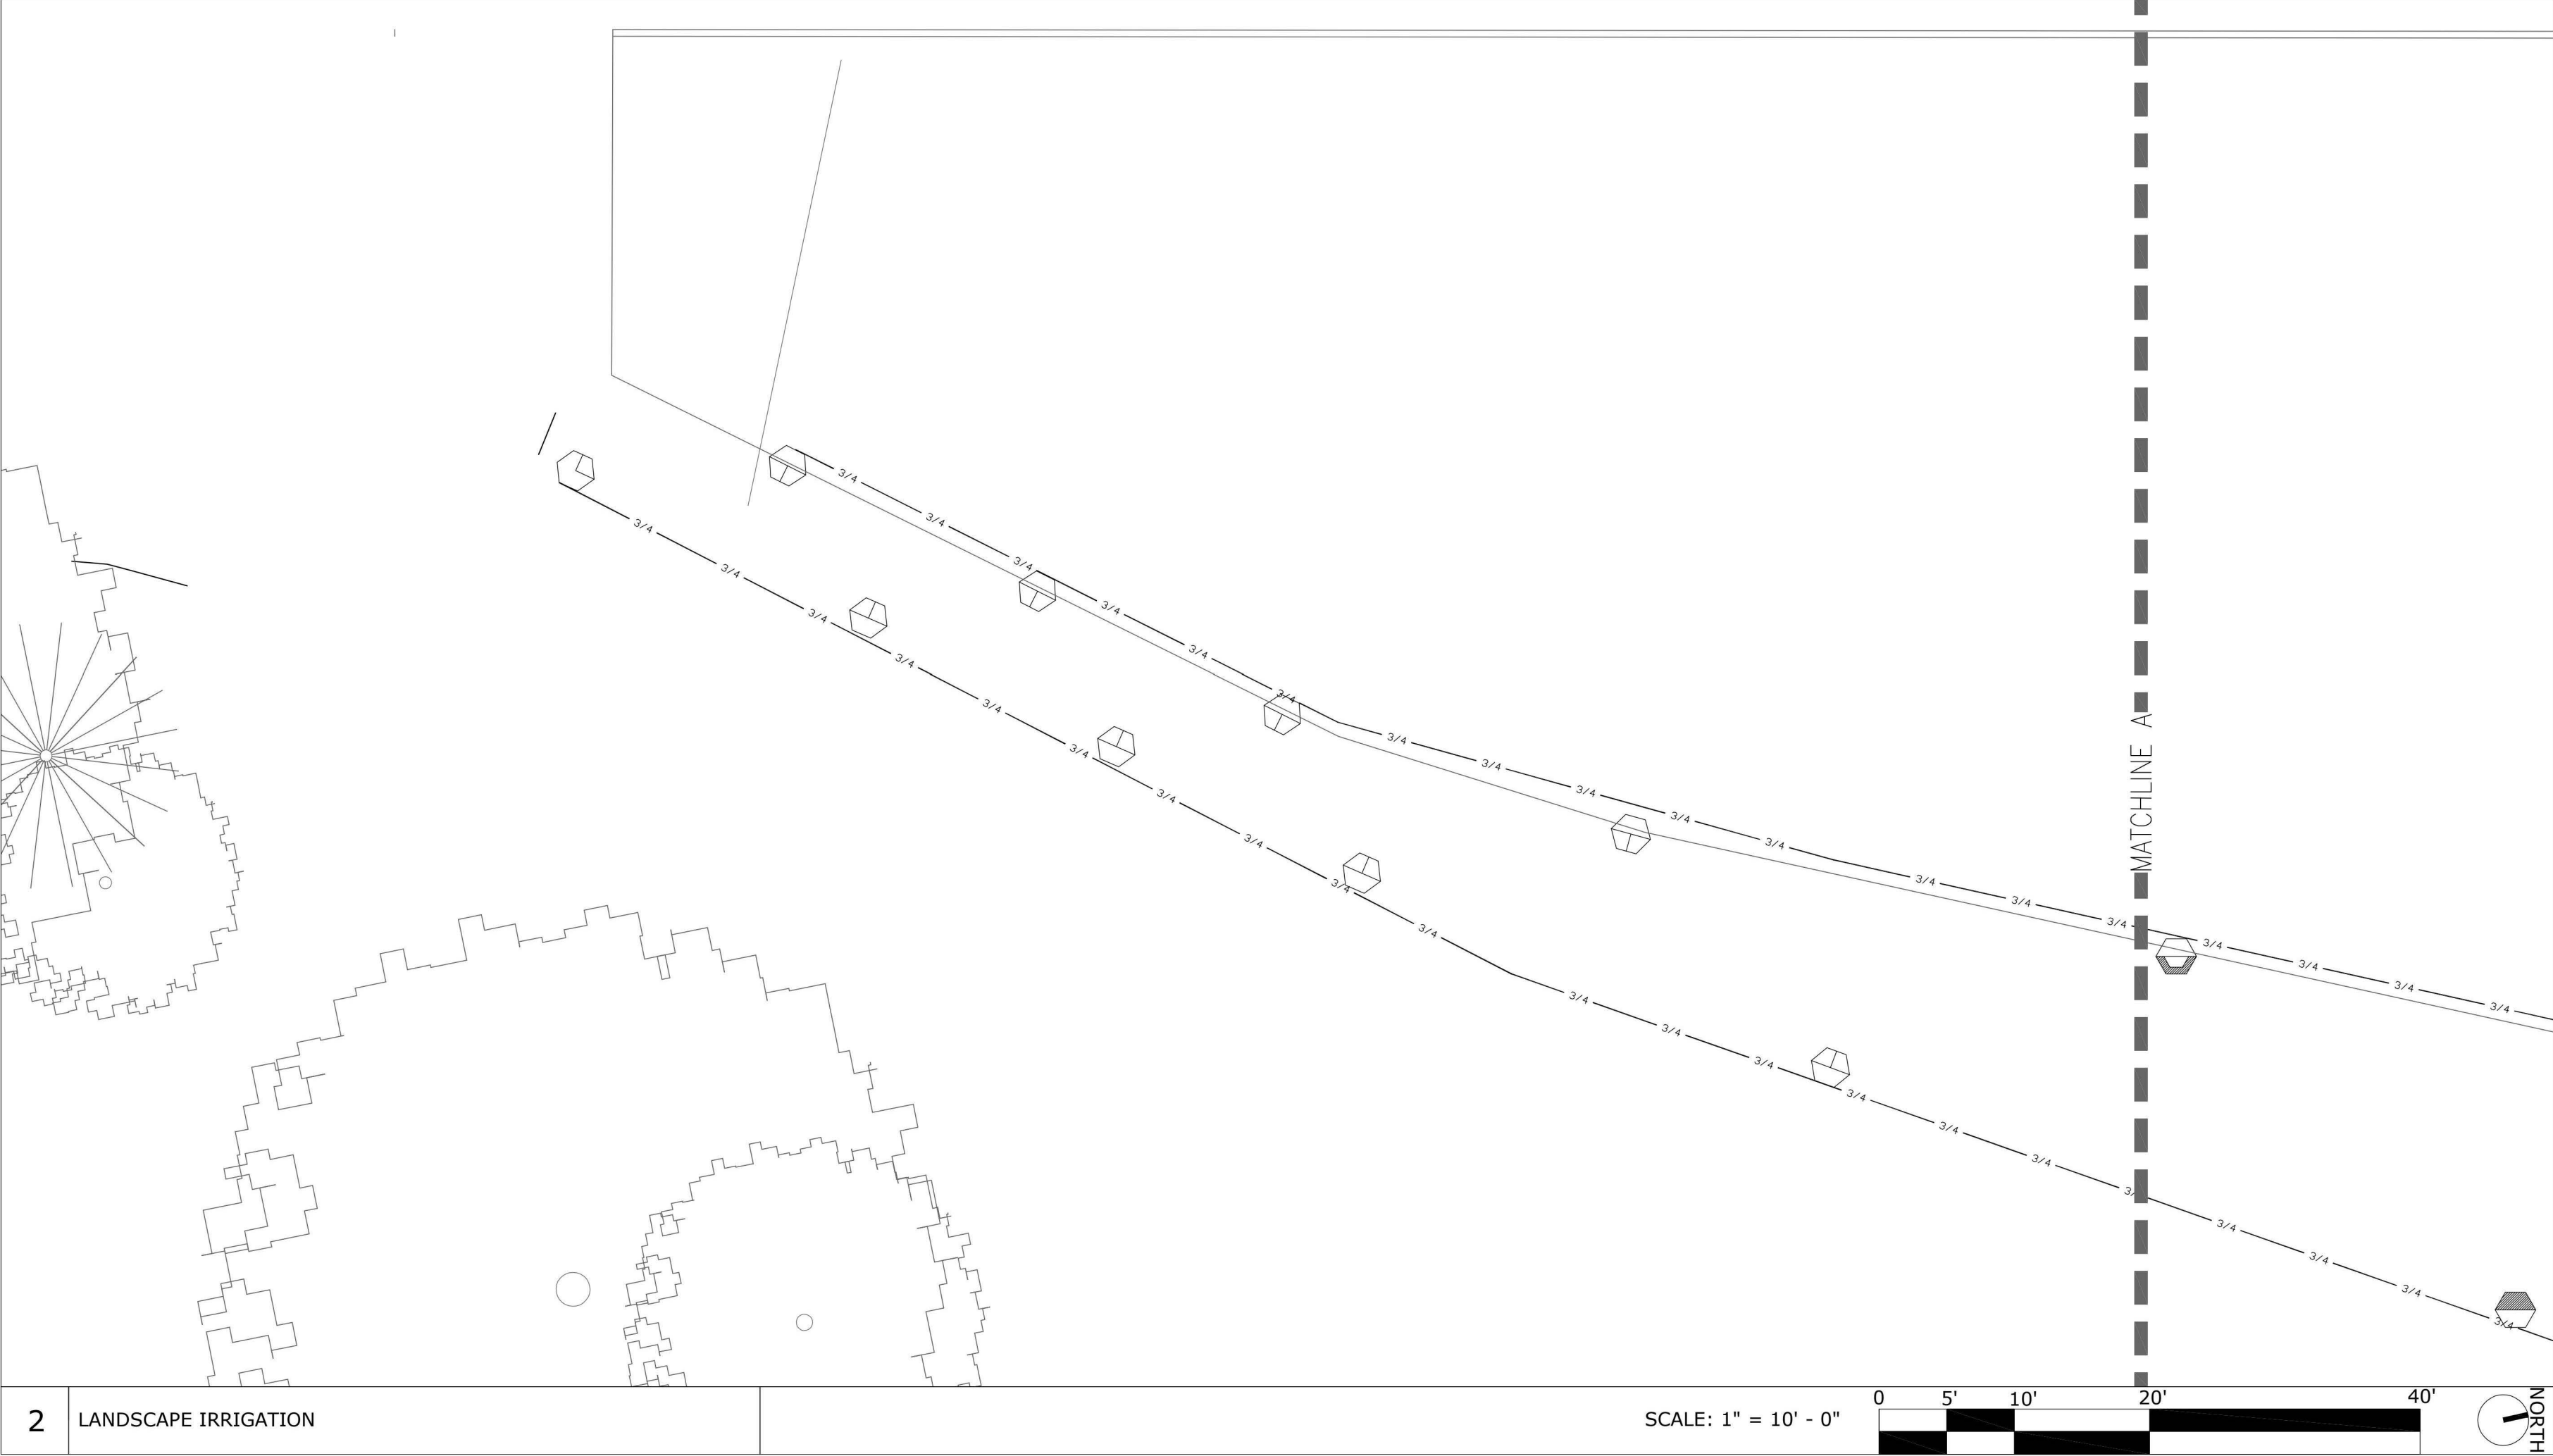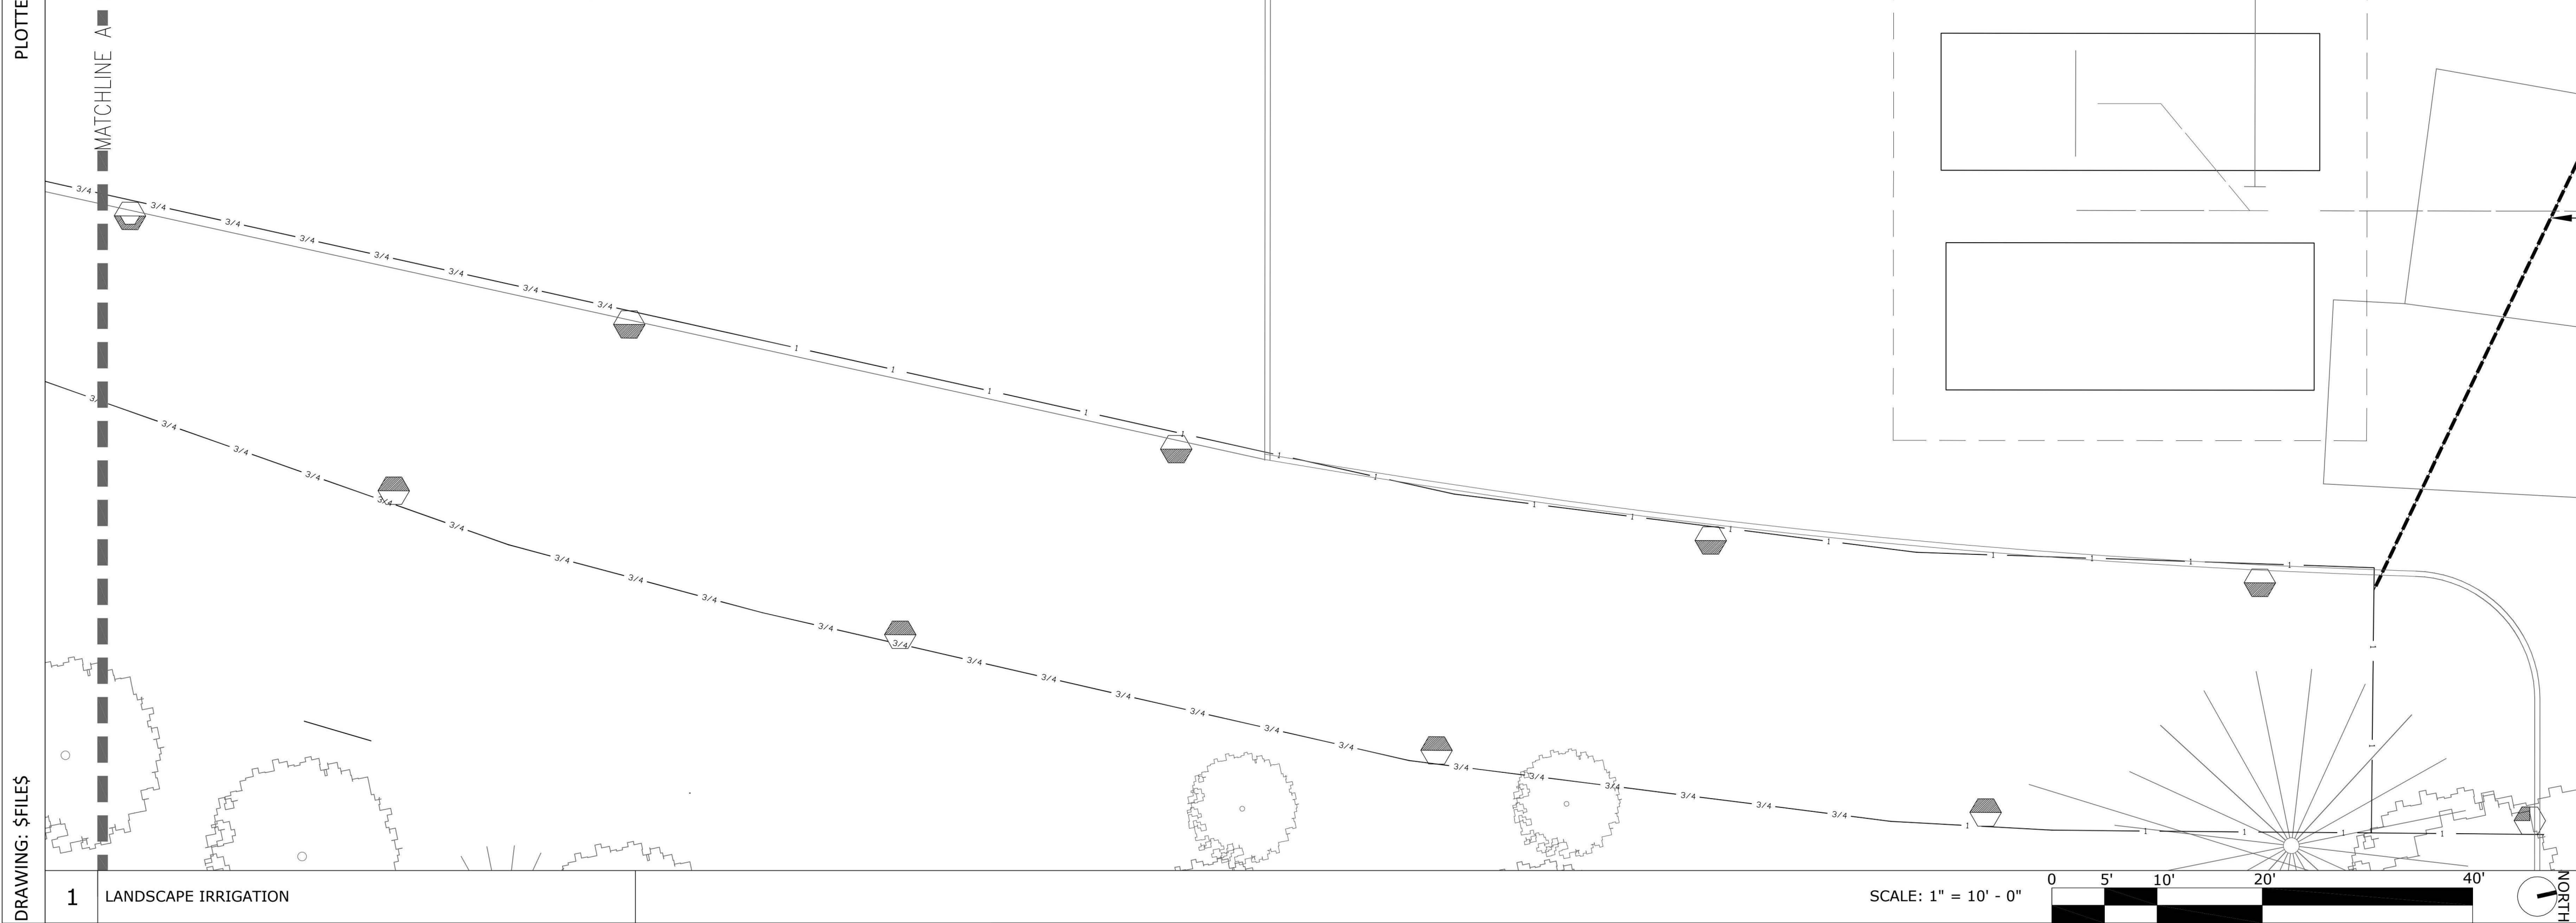

IRRIGATION SCHEDULE			
SPRINKLERS			
SYM.	SPRINKLER BODY NOZZEL	PATTERN	DETAIL
	HUNTER PROS-PRS40-CV* HUNTER MPCORNER	45-105 DEGREES, 8'-15R	11 / L4.0
	HUNTER PROS-PRS40-CV* HUNTER MP1000-90	90-210 DEGREES, 8'-15R	11 / L4.0
	HUNTER PROS-PRS40-CV* HUNTER MP1000-210	210-270 DEGREES, 8'-15R	11 / L4.0
	HUNTER PROS-PRS40-CV* HUNTER MP1000-360	360 DEGREES, 8'-15R	11 / L4.0
	HUNTER PROS-PRS40-CV* HUNTER MP2000-90	90-210 DEGREES, 13'-21R	11 / L4.0
	HUNTER PROS-PRS40-CV* HUNTER M2000-360	360 DEGREES, 13'-21R	11 / L4.0
	HUNTER PROS-PRS40-CV* HUNTER MP3000-90	90-210 DEGREES, 22'-30R	11 / L4.0
	HUNTER PROS-PRS40-CV* HUNTER MP3000-360	360 DEGREES, 22'-30R	11 / L4.0
	HUNTER PROS-PRS40-CV* HUNTER MPSS530	SIDE STRIP 5' X 30'	11 / L4.0
	HUNTER PROS-PRS40-CV* HUNTER MPLCS515	LEFT CORNER 5' X 15'	11 / L4.0
	HUNTER PROS-PRS40-CV* HUNTER MPRCS515	RIGHT CORNER 5' X 15'	11 / L4.0
	HUNTER PROS-06-PRS30 HUNTER PCN-50	TRICKLE BUBBLER	11 / L4.0
	HUNTER PROS-06-PRS30 HUNTER PCN-25	TRICKLE BUBBLER	11 / L4.0
	HUNTER I-20-06-SS	ADJ. ARC, R VARIES	12 / L4.0
	HUNTER I-40-06-SS	ADJ. ARC, R VARIES	12 / L4.0
	HUNTER I-40-06-ON	360 DEGREES, OPPOSING NOZZLES, R VARIES	12 / L4.0
	HUNTER I-20-12 MPR-25-90	90 DEGREES, 19'-25R	12 / L4.0
	HUNTER I-20-12 MPR-25-120	120 DEGREES, 19'-25R	12 / L4.0
	HUNTER I-20-12 MPR-25-180	180 DEGREES, 19'-25R	12 / L4.0
	HUNTER I-20-12 MPR-25-360	360 DEGREES, 19'-25R	12 / L4.0
	HUNTER I-20-12 MPR-30-90	90 DEGREES, 23'-30R	12 / L4.0
	HUNTER I-20-12 MPR-30-120	120 DEGREES, 23'-30R	12 / L4.0
	HUNTER I-20-12 MPR-30-180	180 DEGREES, 23'-30R	12 / L4.0
	HUNTER I-20-12 MPR-30-360	360 DEGREES, 23'-30R	12 / L4.0
	HUNTER I-20-12 MPR-35-90	90 DEGREES, 26'-35R	12 / L4.0
	HUNTER I-20-12 MPR-35-120	120 DEGREES, 26'-35R	12 / L4.0
	HUNTER I-20-12 MPR-35-180	180 DEGREES, 26'-35R	12 / L4.0
	HUNTER I-20-12 MPR-35-360	360 DEGREES, 26'-35R	12 / L4.0
*NOTE: 6" HEIGHT BODIES ARE REQUIRED @ ALL TURF AREAS AND 12" HIGH BODIES ARE REQUIRED @ ALL SHRUB/GROUNDCOVER AREAS.			
IRRIGATION EQUIPMENT			
SYM.	DESCRIPTION	DETAIL	
	TREE ROOT WATERING SYSTEM	1 / L4.1	
	REMOTE CONTROL VAVLE	12 / L4.0	
	QUICK COUPLER VAVLE	8 / L4.0	
	ISOLATION VALVE	5, 6 / L4.0	
	FLOW SENSOR	10 / L4.0	
	IRRIGATION CONTROLLER "A"	1 / L4.0	
	POINT OF CONNECTION	2 / L4.0	
	CLASS 200 PVC LATERAL LINE	4 / L4.0	
	PVC MAIN LINE	4 / L4.0	
	SCH. 40 PVC SLEEVE	3 / L4.0	
IRRIGATION SCHEDULE			
3500 A1 1"		GALLONS PER MINUTE CONTROLLER STATION # VALVE SIZE	

LX-8

LX-9

LX-0

LX-1

LX-2

LX-3

LX-4

LX-14

LX-13

LX-12

LX-11

LX-10

LX-7

LX-6

LX-5

KEY: SHEET LAYOUT

NORTH

L

A

LANDO AND ASSOCIATES
LANDSCAPE ARCHITECTS
5607 SE SCOTT DRIVE
PORTLAND | OREGON | 97215
503.231.6600 | Lando_LandscapeArchitecture.com

NOTE:
SCALE INDICATED ON DRAWING
IS CORRECT IF DRAWING
BORDER IS 22" X 34".

PORTLAND
PARKS & RECREATION

Healthy Parks, Healthy Portland

503.525.9511
www.opsisarch.com
920 NORTHWEST SEVENTEENTH AVENUE
PORTLAND | OREGON | 97209
copyright 2016 opsis architecture llp
ALL RIGHTS RESERVED

PERMIT / BID SET
08.30.2018

Portland Parks and Recreation
Ananda Fritz, Commissioner Kira Selley, Intern Director

Landscape Irrigation Plan
Urban Forestry Maintenance Facility
PROJECT MANAGER: ROBIN LAUGHLIN

DATE: 10.04.2019 SCALE: DRAWN BY: PL SECTION:

REVISIONS

DATE	DESCRIPTION	BY

P

A

R


K

S

REPLACEMENT
BOND
2014


L2-1

Job No.
4655-01

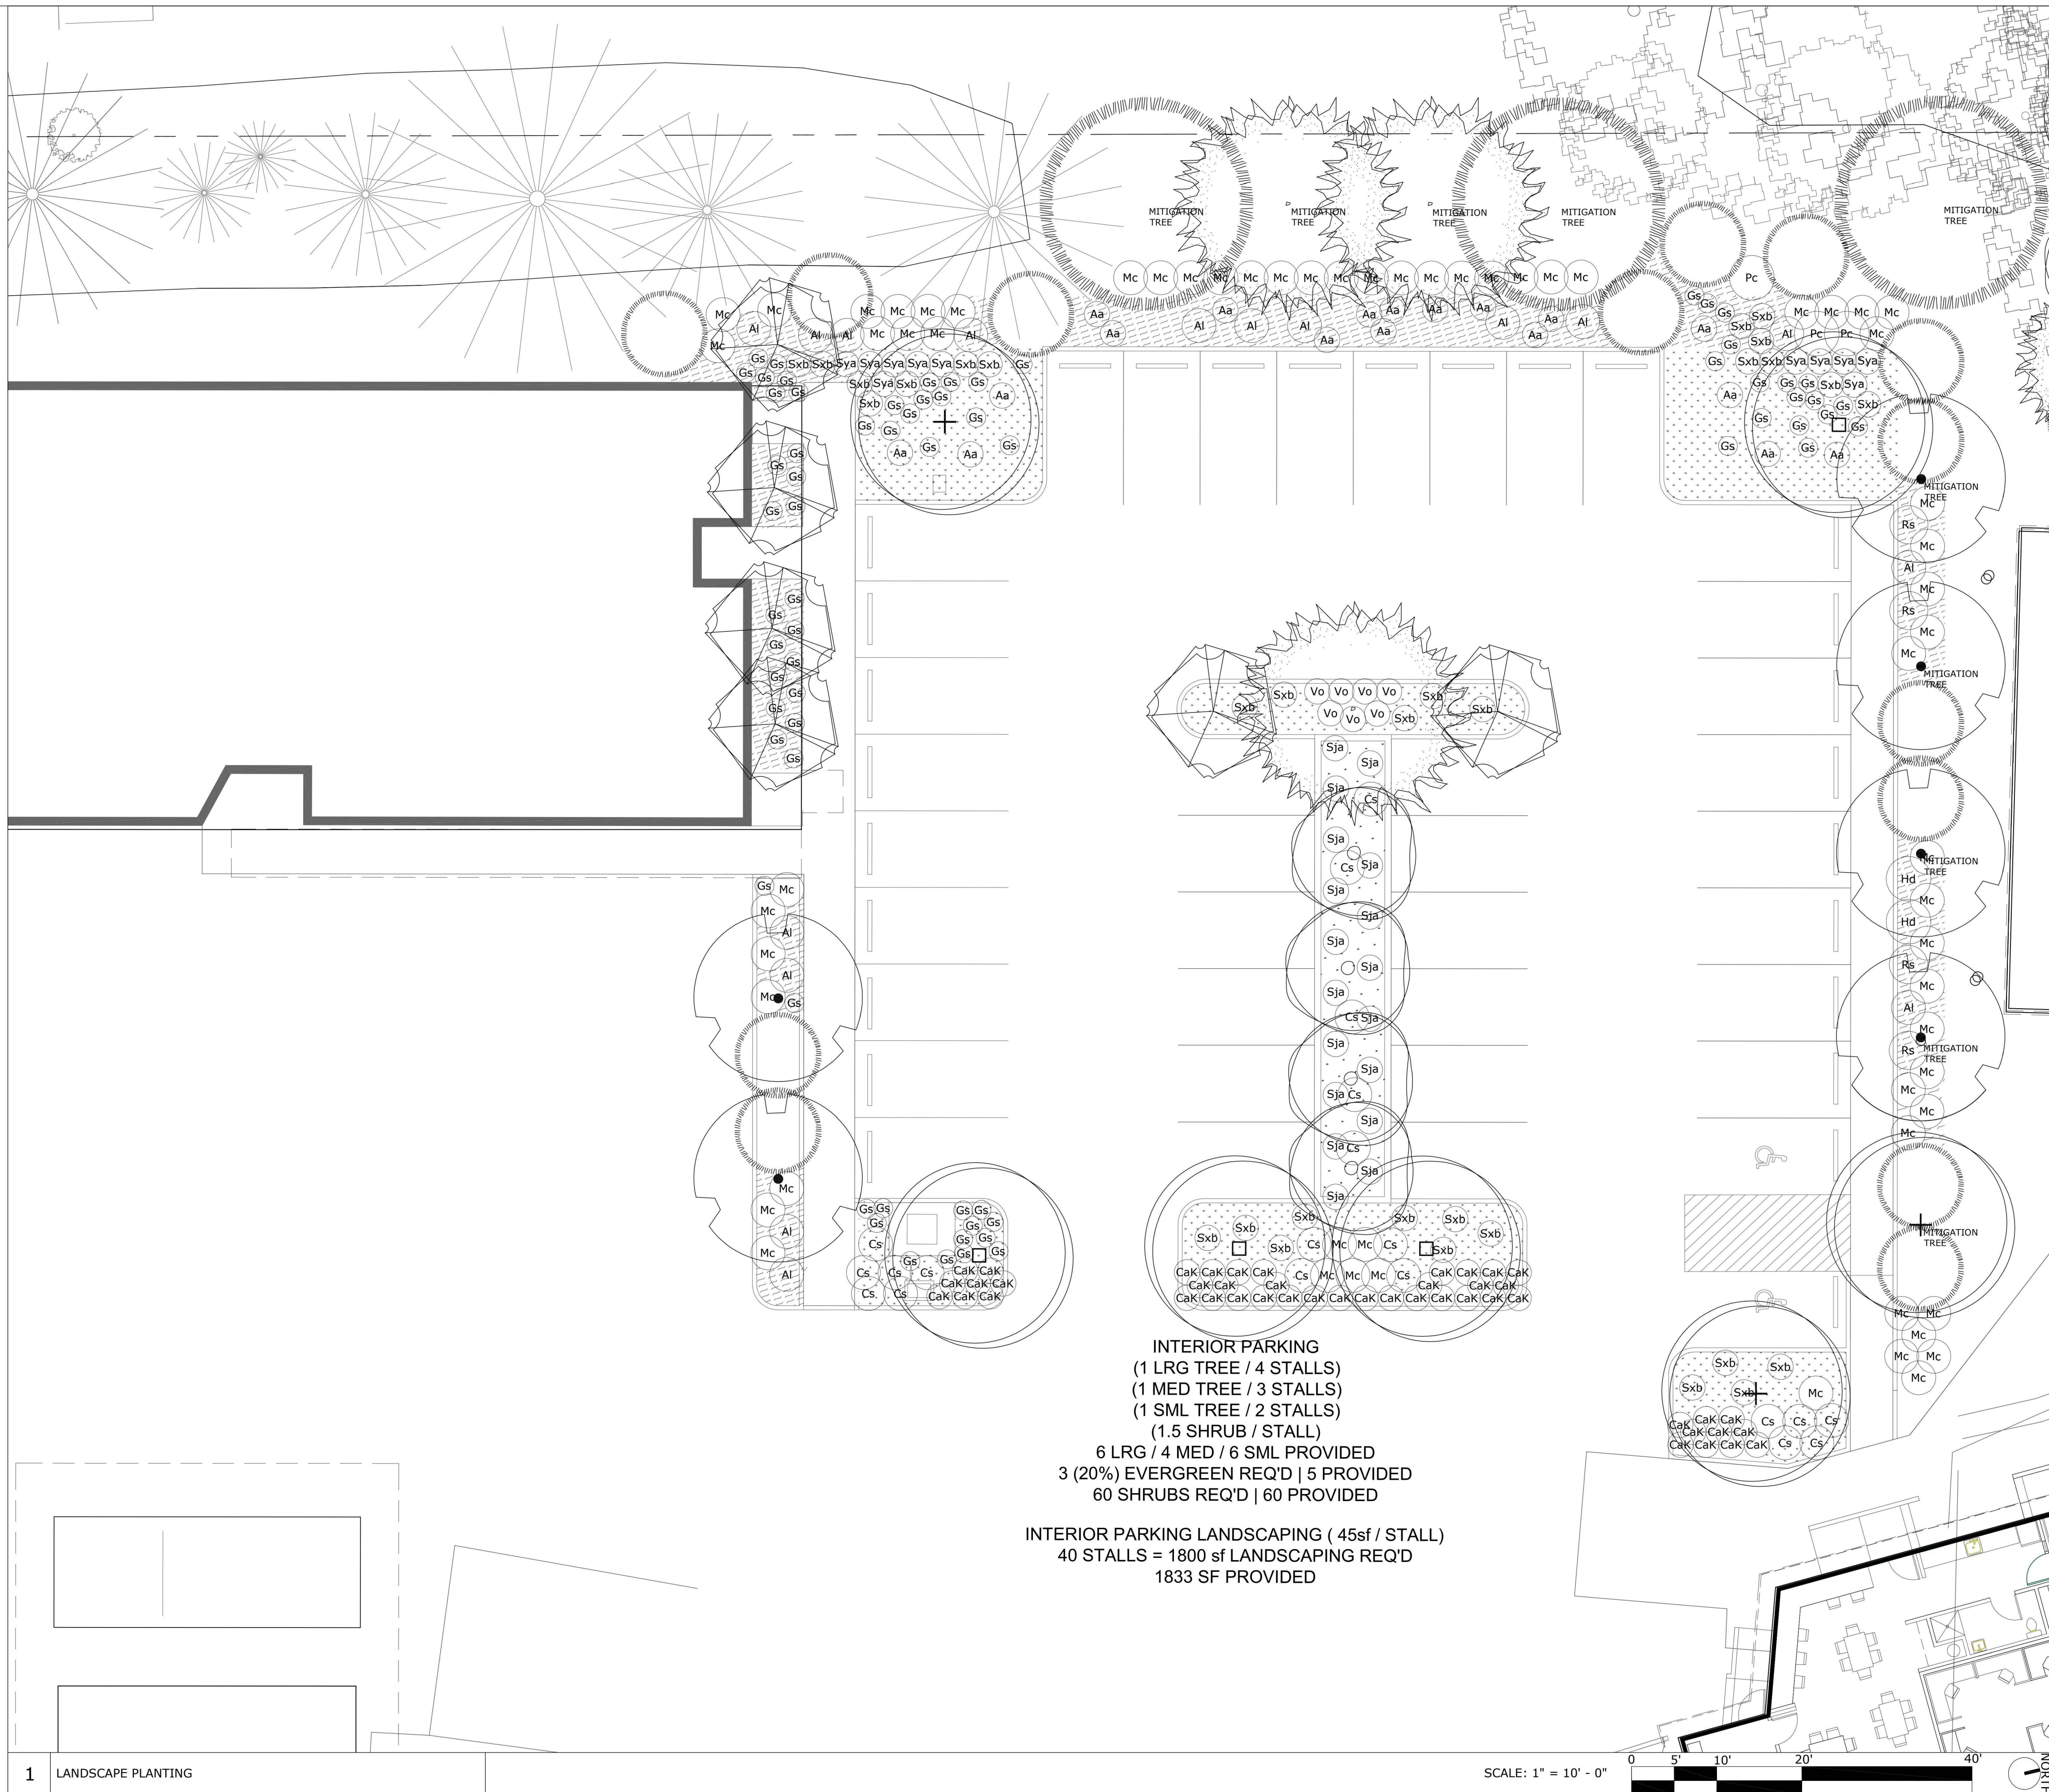

PLANT SCHEDULE				
SYMBOL	#	SCIENTIFIC NAME	COMMON NAME	SIZE
	6	FRAXINUS LATIFOLIA	OREGON ASH	2" CAL
	3	ALNUS RUBRA	RED ALDER	2" CAL
	15	CHAMAECYPARIS OBTUSA	HINKOY CYPRESS	6-7FT
	6	CORNUS NUTTALLII 'EDDIE'S W.W.' PACIFIC DOGWOOD		2" CAL
	4	BETULA NIGRA	RIVER BIRCH	10 GAL
	7	PSUEDOTSUGA MENZIESII	DOUGLAS FIR	6-7FT
	2	SEQUOIA ENDERSONI GIGANTEUM	GIANT SEQUOIA	3" CAL
	3	THUJA PLICATA	WESTERN RED CEDAR	3" CAL
Al	15	AMELANCHIER LAEVIS	SERVICEBERRY	5 gal
Ap	16	AMELANCHIER ALNIFOLIA	SHRUB SERVICEBERRY	5 gal
Cs	46	CSAMAGRA A. 'KARL FORSTER'	FEATHER REED GRASS	1 gal
Cs	20	STOR. STOLONIFERA 'OCCID.'	RED-OSIER DOGWOOD	3 gal
Hd	60	GAULTHERIA SHALLON	SALAL	1 gal
Mc	63	HOLODISCUS DISCOLOR	OCEAN SPRAY	10 gal
Pc	27	MYRTICA CALIFORNICA	PACIFIC WAX MYRTLE	10 gal
Sja	2	PHYSCOCARPUS CAPITATUS	NINEBARK	5 gal
Sxb	4	RIBES SANGUINEUM	RED FLOWERING CURRANT	5 gal
Sya	18	SPIREA JAP. ALBA	JAP. WHITE SPIREA	3 gal
Vo	27	SPIREA X BUMALDA	GOLD FLAME SPIREA	3 gal
	11	SYMPHORICARPOS ALBA	SNOWBERRY	2 gal
	7	VACCINIUM OVATUM	EVERGREEN HUCKLEBERRY	5 gal

	PLANT MIX #1: STORMWATER SWALE @ PARKING LOT - 12" O.C.			
45	CAREX OBNUPTA	SLOUGH SEDGE	4"	POTS
20	CAMASSIA QUAMASH	CAMAS	4"	POTS
25	DESCHAMPSIA CESPITOSA	TUFTED FAIRGRASS	SEED	
55	IRIS DOUGLASIANA	DOUGLAS IRIS	4"	POTS
PLANT MIX B1 - 12" O.C.				
	60% ARCTOSTAPHYLOS UVA URSI	KINNICKINNICK	4"	POT
20%	FRAGARIA VIRGINIANA	WILD STRAWBERRY	4"	POT
20%	GAULTHERIA SHALLON	SALAL	1	GAL
10%	MAHONIA NERVOSA 'COMPACTA'	LOW OREGON GRAPE	1	gal
PLANT MIX C1 - 12" O.C.				
	40% ARCTOSTAPHYLOS UVA URSI	KINNICKINNICK	4"	POTS
10%	BLECHNUM SPICANT	DEER FERN	1	GAL
10%	DICENTRA FORMOSA	SPECIFIC BLEEDING HEART	4"	POT
20%	POLYSTICHUM MUNITUM	SWORD FERN	1	GAL
20%	MAHONIA NERVOSA 'COMPACTA'	LOW OREGON GRAPE	1	gal

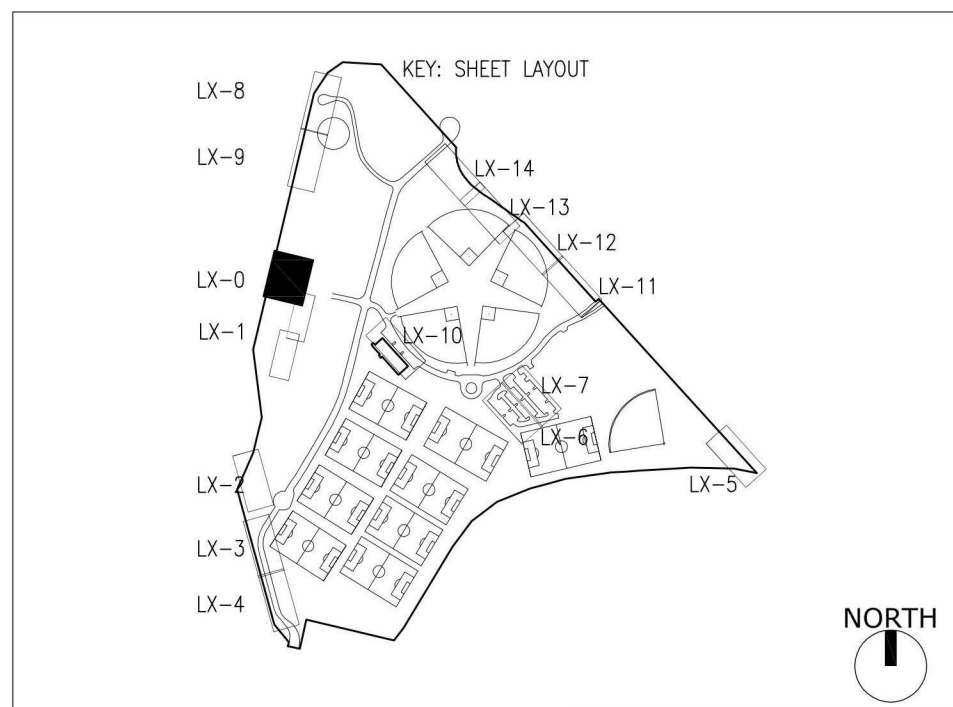

NOTE:
SCALE INDICATED ON DRAWING
IS CORRECT IF DRAWING
BORDER IS 22" X 34".

REVISIONS		
DATE	DESCRIPTION	BY




PLOTTED FROM: \$COMPUTERNAME\$

PLOTTED BY: \$USERNAME\$



PLOTTED ON: \$DATE\$

DRAWING: \$FILE\$

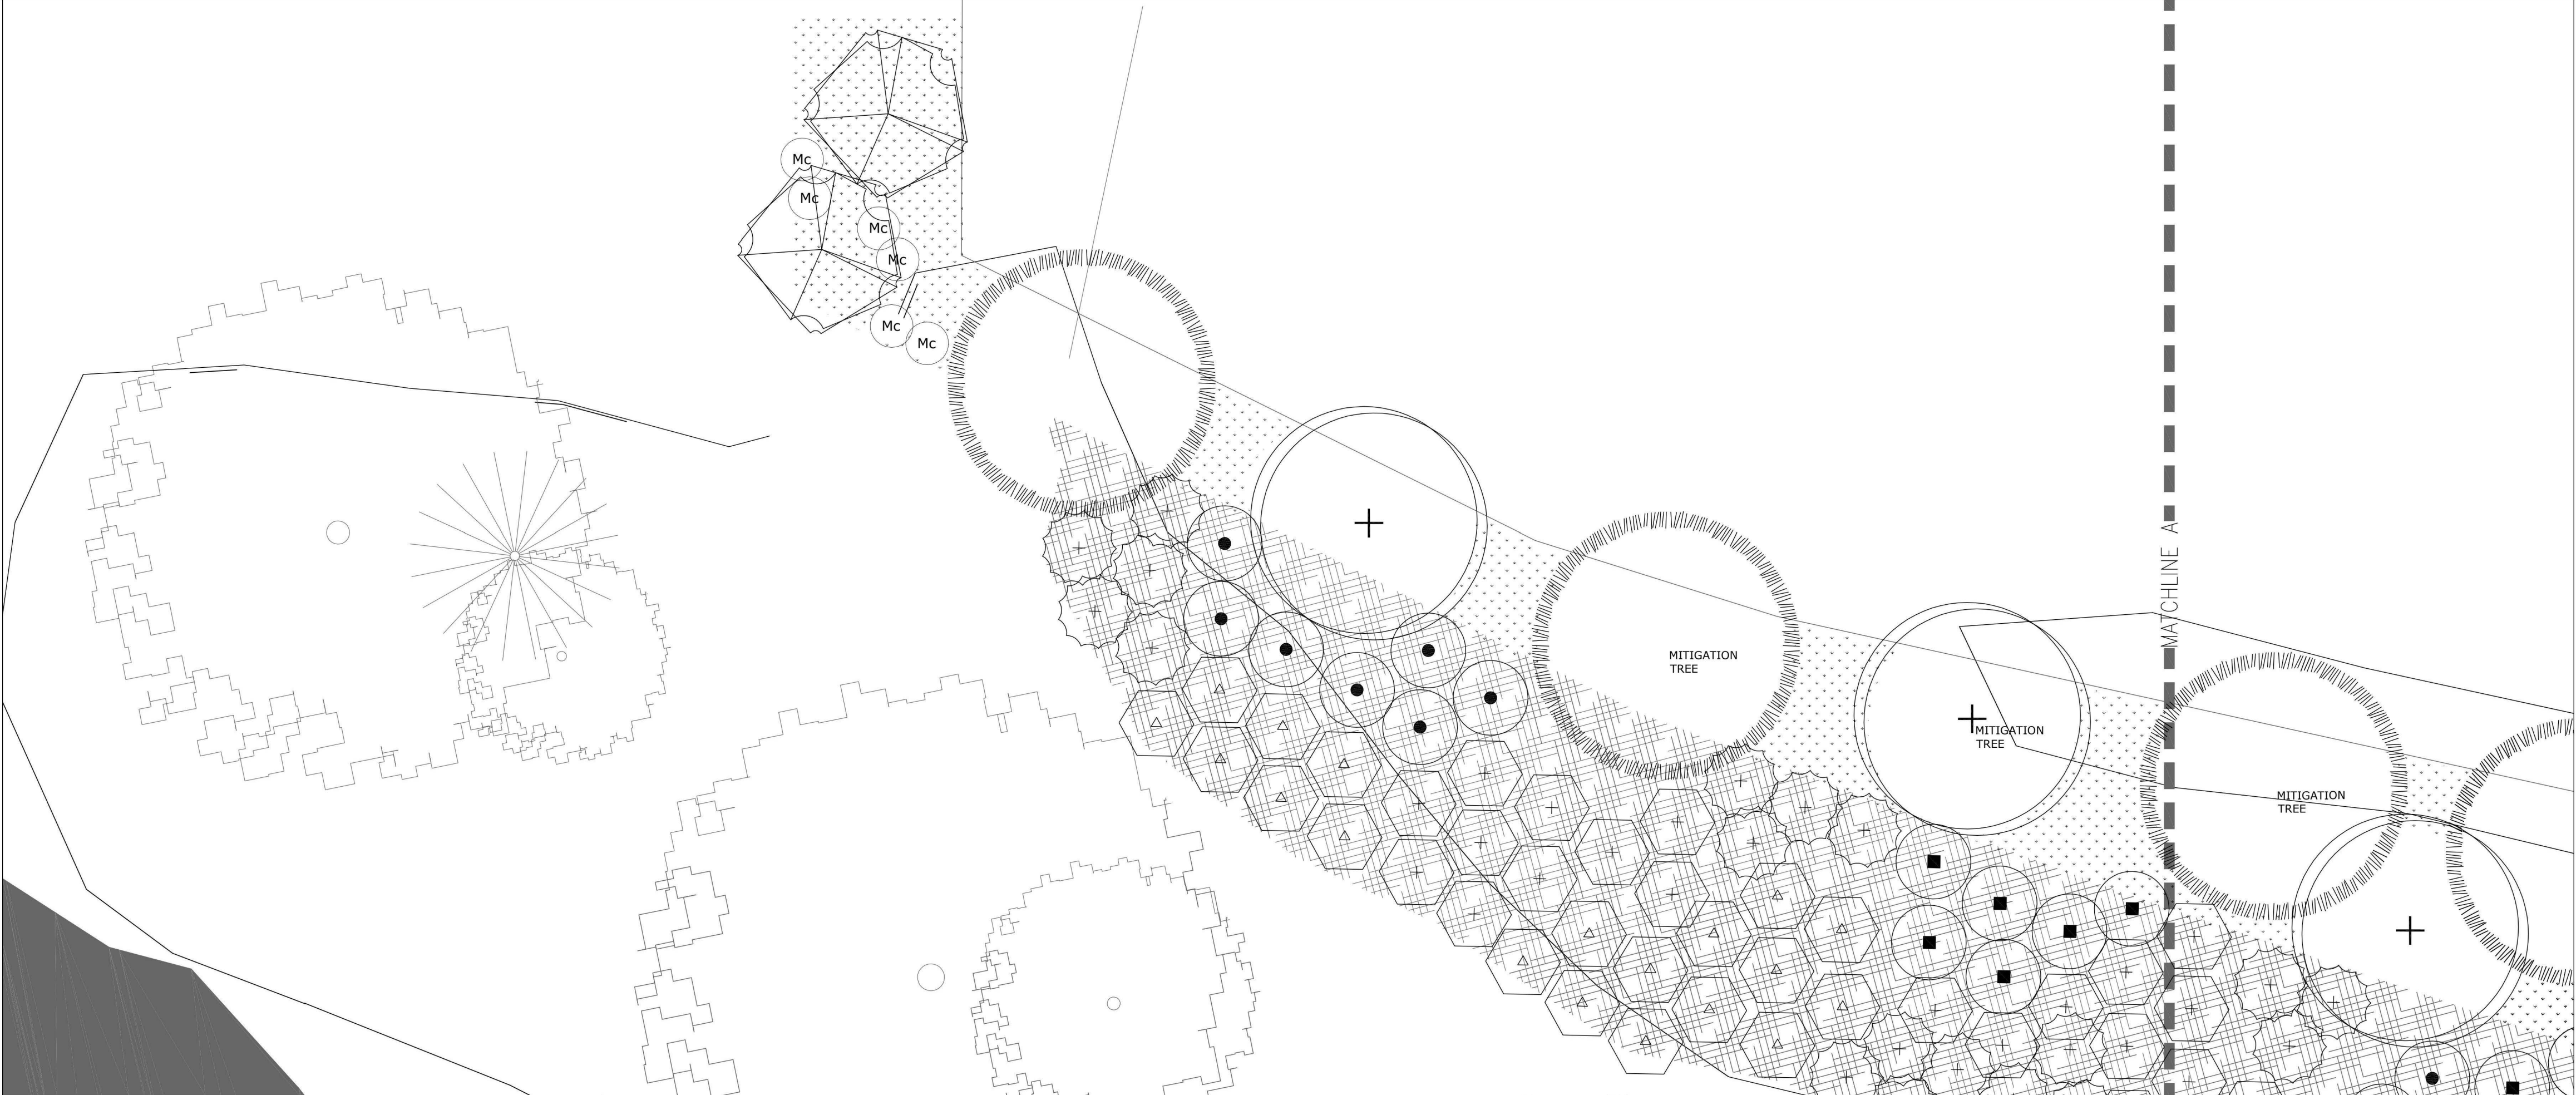


2 LANDSCAPE PLANTING

SCALE: 1" = 10' - 0"

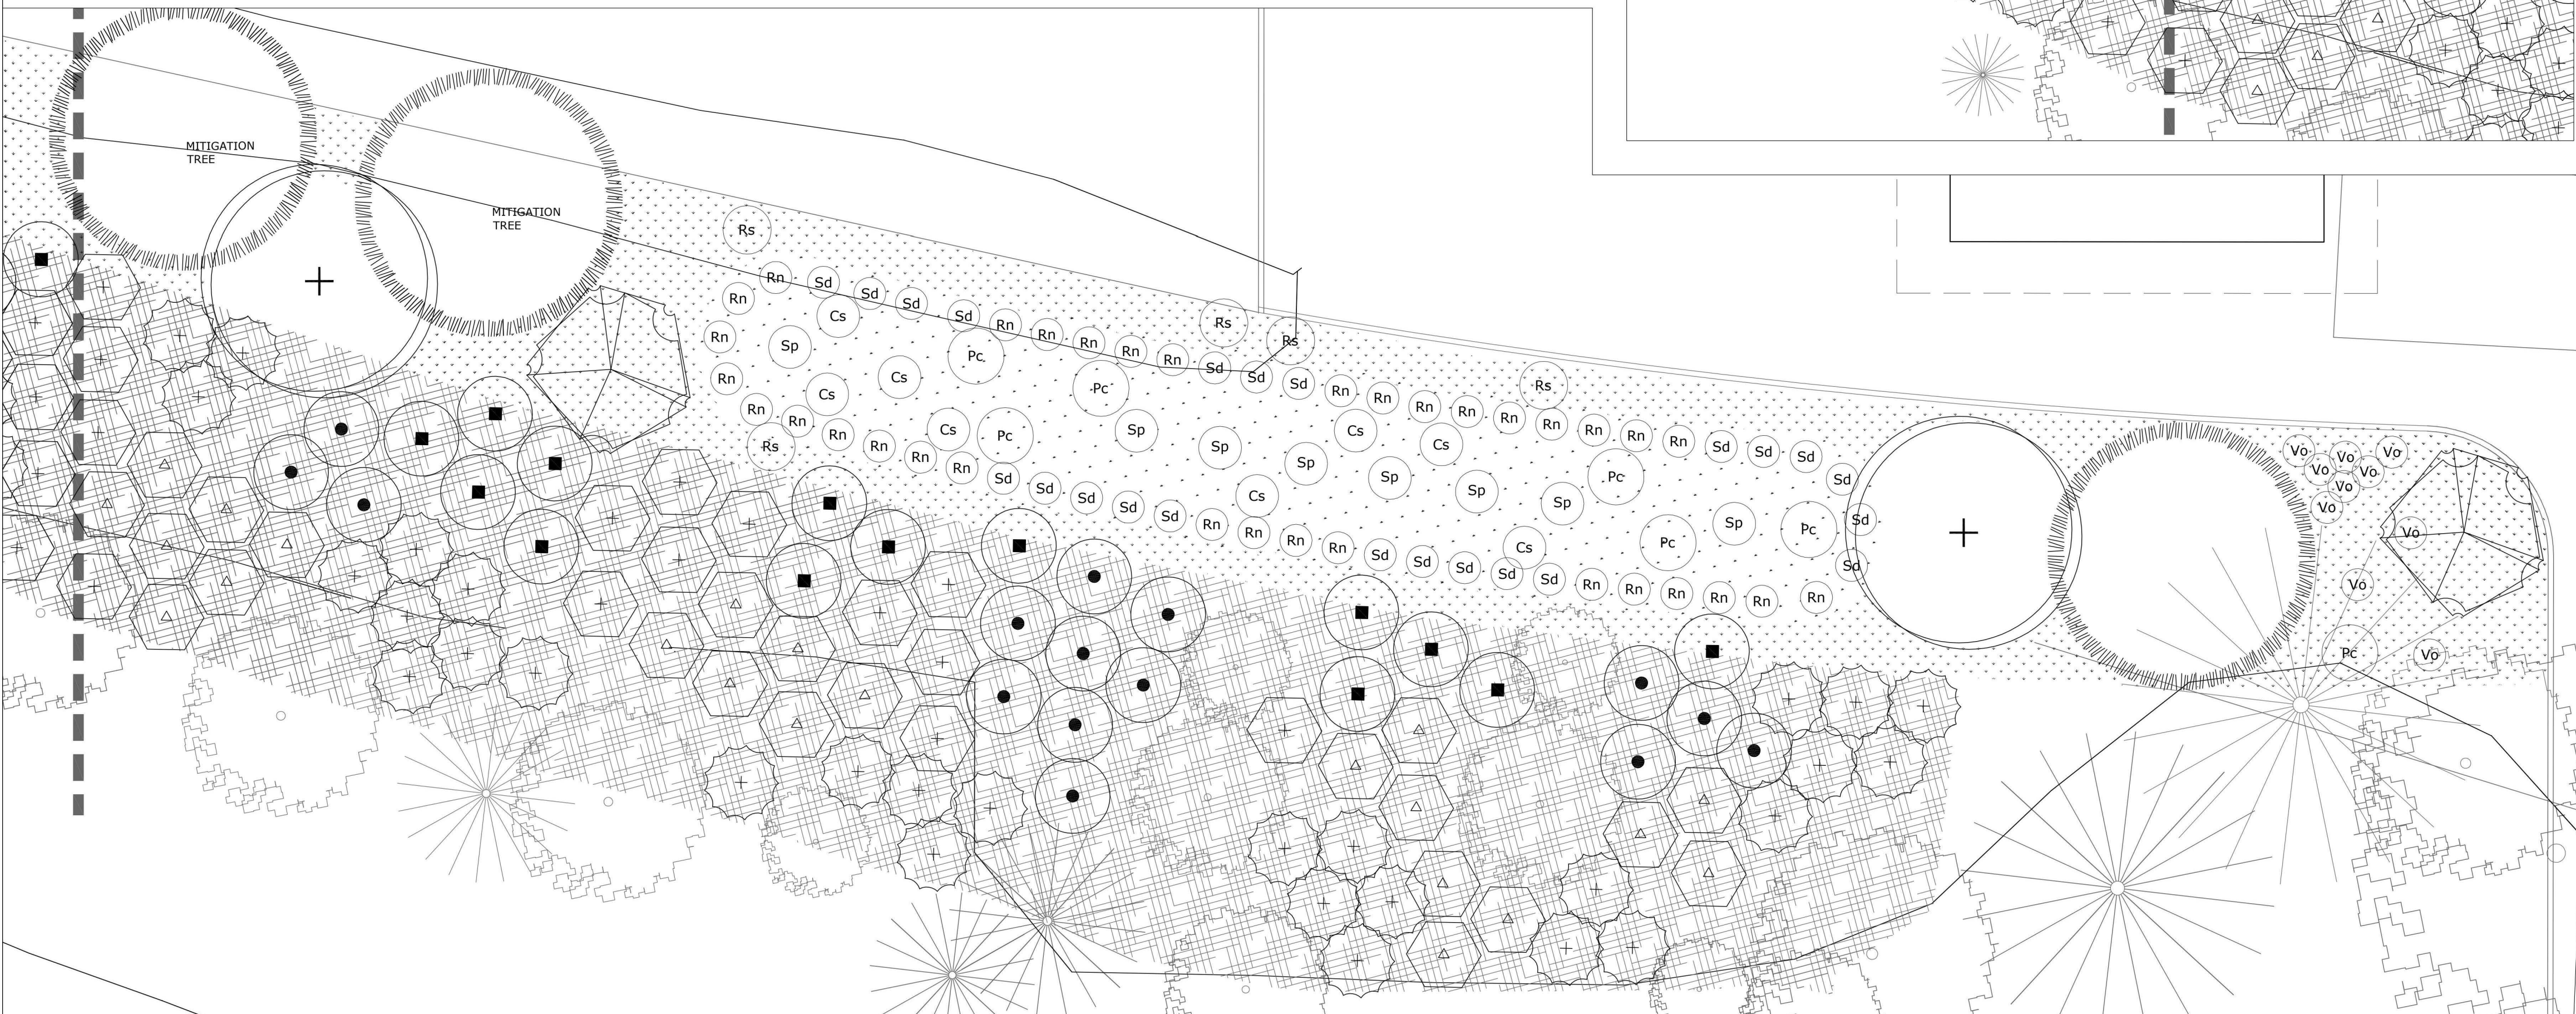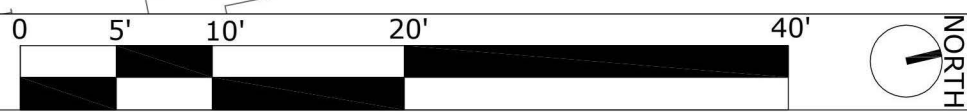

1 LANDSCAPE PLANTING

SCALE: 1" = 10' - 0"

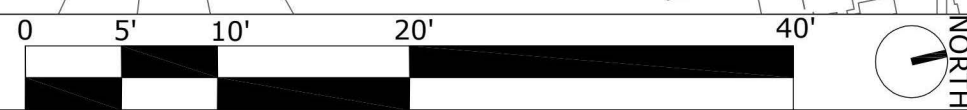

PLANT SCHEDULE				
SYMBOL	#	SCIENTIFIC NAME	COMMON NAME	SIZE
	4	CORNUS NUTTALLII	EDDIE'S W.W. PACIFIC DOGWOOD	2" CAL
	5	PSEUDOTSUGA MENZEISII	DOUGLAS FIR	3" CAL
	6	THUJA PLICATA	WESTERN RED CEDAR	3" CAL
	8	COR. STOLONIFERA 'OCCID.'	RED-OSIER DOGWOOD	3 gal
	16	MYRICA CALIFORNICA	PACIFIC WAX MYRTLE	10 gal
	7	PHYSOCARPUS CAPITATUS	NINEBARK	5 gal
	5	TRIBES SANGUINEUM	RED FLOWERING CURRANT	5 gal
	34	ROSA NUTKANA	NOOTKA ROSE	1 gal
	8	SALIX SITCHENSIS	SITKA WILLOW	5 gal
	23	SPIRAEA DOUGLASII	WESTERN SPIRAEA	3 gal
	10	VACCINIUM OVATUM	EVERGREEN HUCKLEBERRY	5 gal


PLANT MIX A2: STORMWATER SWALE @ TRANSITION ZONE - 18" O.C.
1180 CAREX OBNUPA SLUGH SEDGE 4" POTS
DESCHAMPSIA CESPIOSA TUFTED HAIRGRASS SEED

PLANT MIX B2 - 12" O.C.
60% ARCTOSTAPHYLOS UVA URSI KINNICKINICK 4" POT
20% FRAGARIA VIRGINIANA WILD STRAWBERRY 4" POT
10% GAULTHERIA SHALLON SALAL 1 GAL
10% MAHONIA NERVOSA 'COMPACTA' LOW OREGON GRAPE 1 gal

RESTORATION AREA PLANT SCHEDULE				
SYMBOL	#	SCIENTIFIC NAME	COMMON NAME	SIZE
	22	ACER MACROCARPA	BIG LEAF MAPLE	1.5" CAL
	32	ALNUS RUBRA	RED ALDER	1.5" CAL
	20	CRATEAGUS DOUGLASII	HAWTHORN	1.5" CAL
	42	FRAXINUS LATIFOLIA	OREGON ASH	1.5" CAL
	46	THUJA PLICATA	WESTERN RED CEDAR	5FT TALL
RESTORATION SHRUB MIX; PLANT IN GROUPS OF 5-7				

SPACING O.C.	#	SCIENTIFIC NAME	COMMON NAME	SIZE
36"	164	AMELANCHIER ALNIFOLIA	SASSAKATOON	1 GAL
36"	164	BERBERIS NERVOSA	CREeping OREGON GRAPE	1 GAL
36"	164	GAULTHERIA SHALLON	SALAL	1 GAL
72"	82	OEMLERIA CERASIFORMIS	INDIAN PLUM	1 GAL
36"	164	PHYSOCARPUS CAPITATUS	NINEBARK	1 GAL
72"	82	SAMBUCUS RACEMOSA	RED ELDERBERRY	1 GAL
36"	164	SPIRAEA DOUGLASII	WESTERN SPIRAEA	1 GAL
36"	164	SYMPHORICARPOS ALBA	SNOWBERRY	1 GAL

	RESTORATION SEEDING		LBS. / ACRE	
	1.4 lbs	BROMUS VULGARIS	COLUMBIA BROME	7
	2.1 lbs	ELYMUS GLAUCUS	BLUE WILD RYE	10
	1.6 lbs	ELYMUS TRACHYCAULUS	SLENDER WILD RYE	8
	2.1 lbs	FESTUCA SUBULATA	BEARDED FESCUE	10

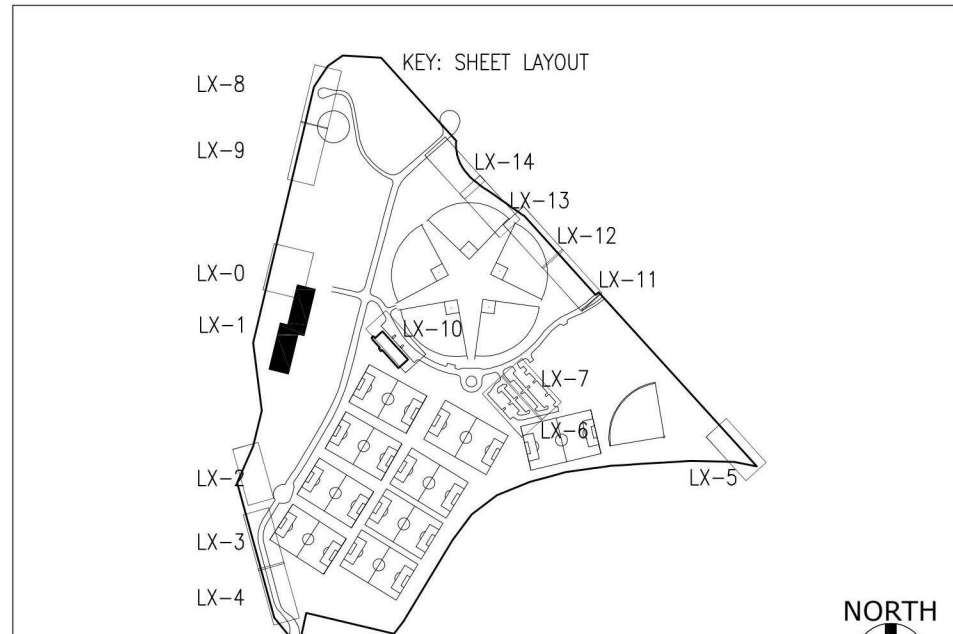

LAND AND ASSOCIATES
landscape architecture
6607 SE SCOTT DRIVE
PORTLAND | OREGON | 97215
503.231.6600 | Land_Associates@landandassociates.com


NOTE:
SCALE INDICATED ON DRAWING
IS CORRECT IF DRAWING
BORDER IS 22" X 34".

**PORTLAND
PARKS & RECREATION**
Healthy Parks, Healthy Portland

opsis

503.525.9511
www.opsisarch.com
920 NORTHWEST SEVENTEENTH AVENUE
PORTLAND | OREGON | 97209
copyright 2016 opsis architecture llp
ALL RIGHTS RESERVED

PERMIT / BID SET
08.30.2018

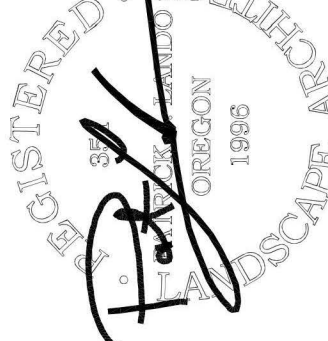

Portland Parks and Recreation
Ananda Fritz, Commissioner Kira Selley, Interm Director

Landscape Planting Plan
Urban Forestry Maintenance Facility
10910 N Denver, Portland, OR 97217
PROJECT MANAGER: ROBIN LAUGHLIN

SECTION:

DRAWN BY: PL

SCALE:

DATE: 10.04.2019

REVISIONS


DATE	DESCRIPTION	BY

**PARKS
REPLACEMENT
BOND
2014**


L3-1

Job No.
4655-01

DRAWING: \$FILE\$ PLOTTED ON: \$DATE\$ PLOTTED BY: \$USERNAME\$ PLOTTED FROM: \$COMPUTERNAME\$

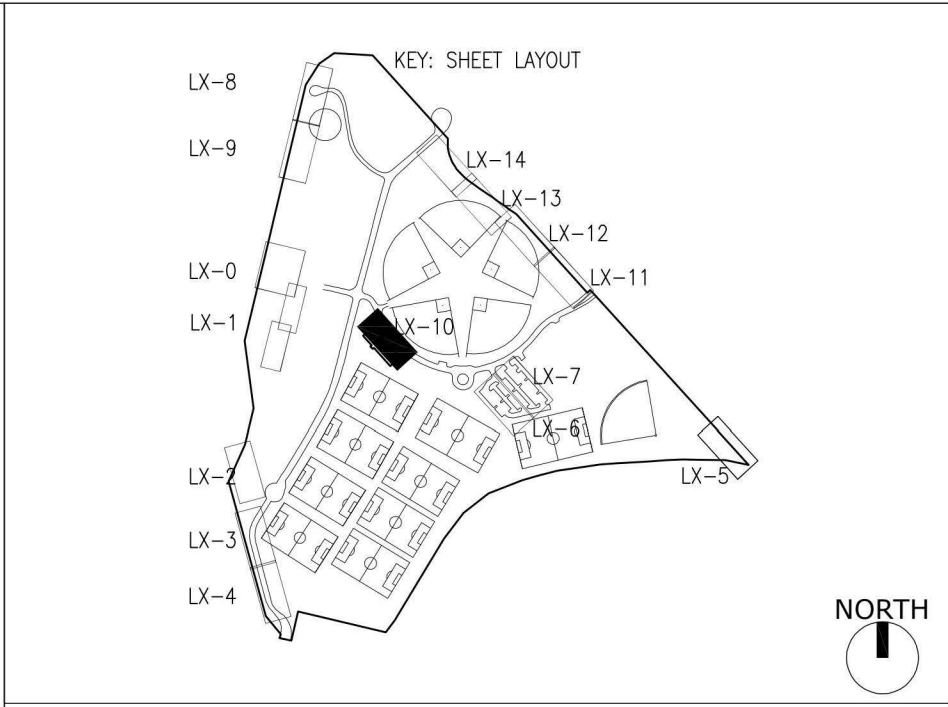

PLANT SCHEDULE - TREES				
SYMBOL	#	SCIENTIFIC NAME	COMMON NAME	SIZE
□	1	QUERCUS MYRSINIFOLIA	RING-CUPPED OAK	3" CAL
⊙	9	ESCALLONIA BIFIDA 'COMPACT WHITE'	ESCALLONIA	3" CAL
PLANT MIX A - 12" O.C.				
▨	40%	ARCTOSTAPHYLOS UVA URSI	KINNICKINICK	4" POTS
	10%	BLECHNUM SPICANT	DEER FERN	1 GAL
	10%	DICENTRA FORMOSA	PACIFIC BLEEDING HEART	4" POT
	20%	POLYSTICHUM MUNITUM	SWORD FERN	1 GAL
	20%	MAHONIA NERVOSA 'COMPACTA'	LOW OREGON GRAPE	1 gal

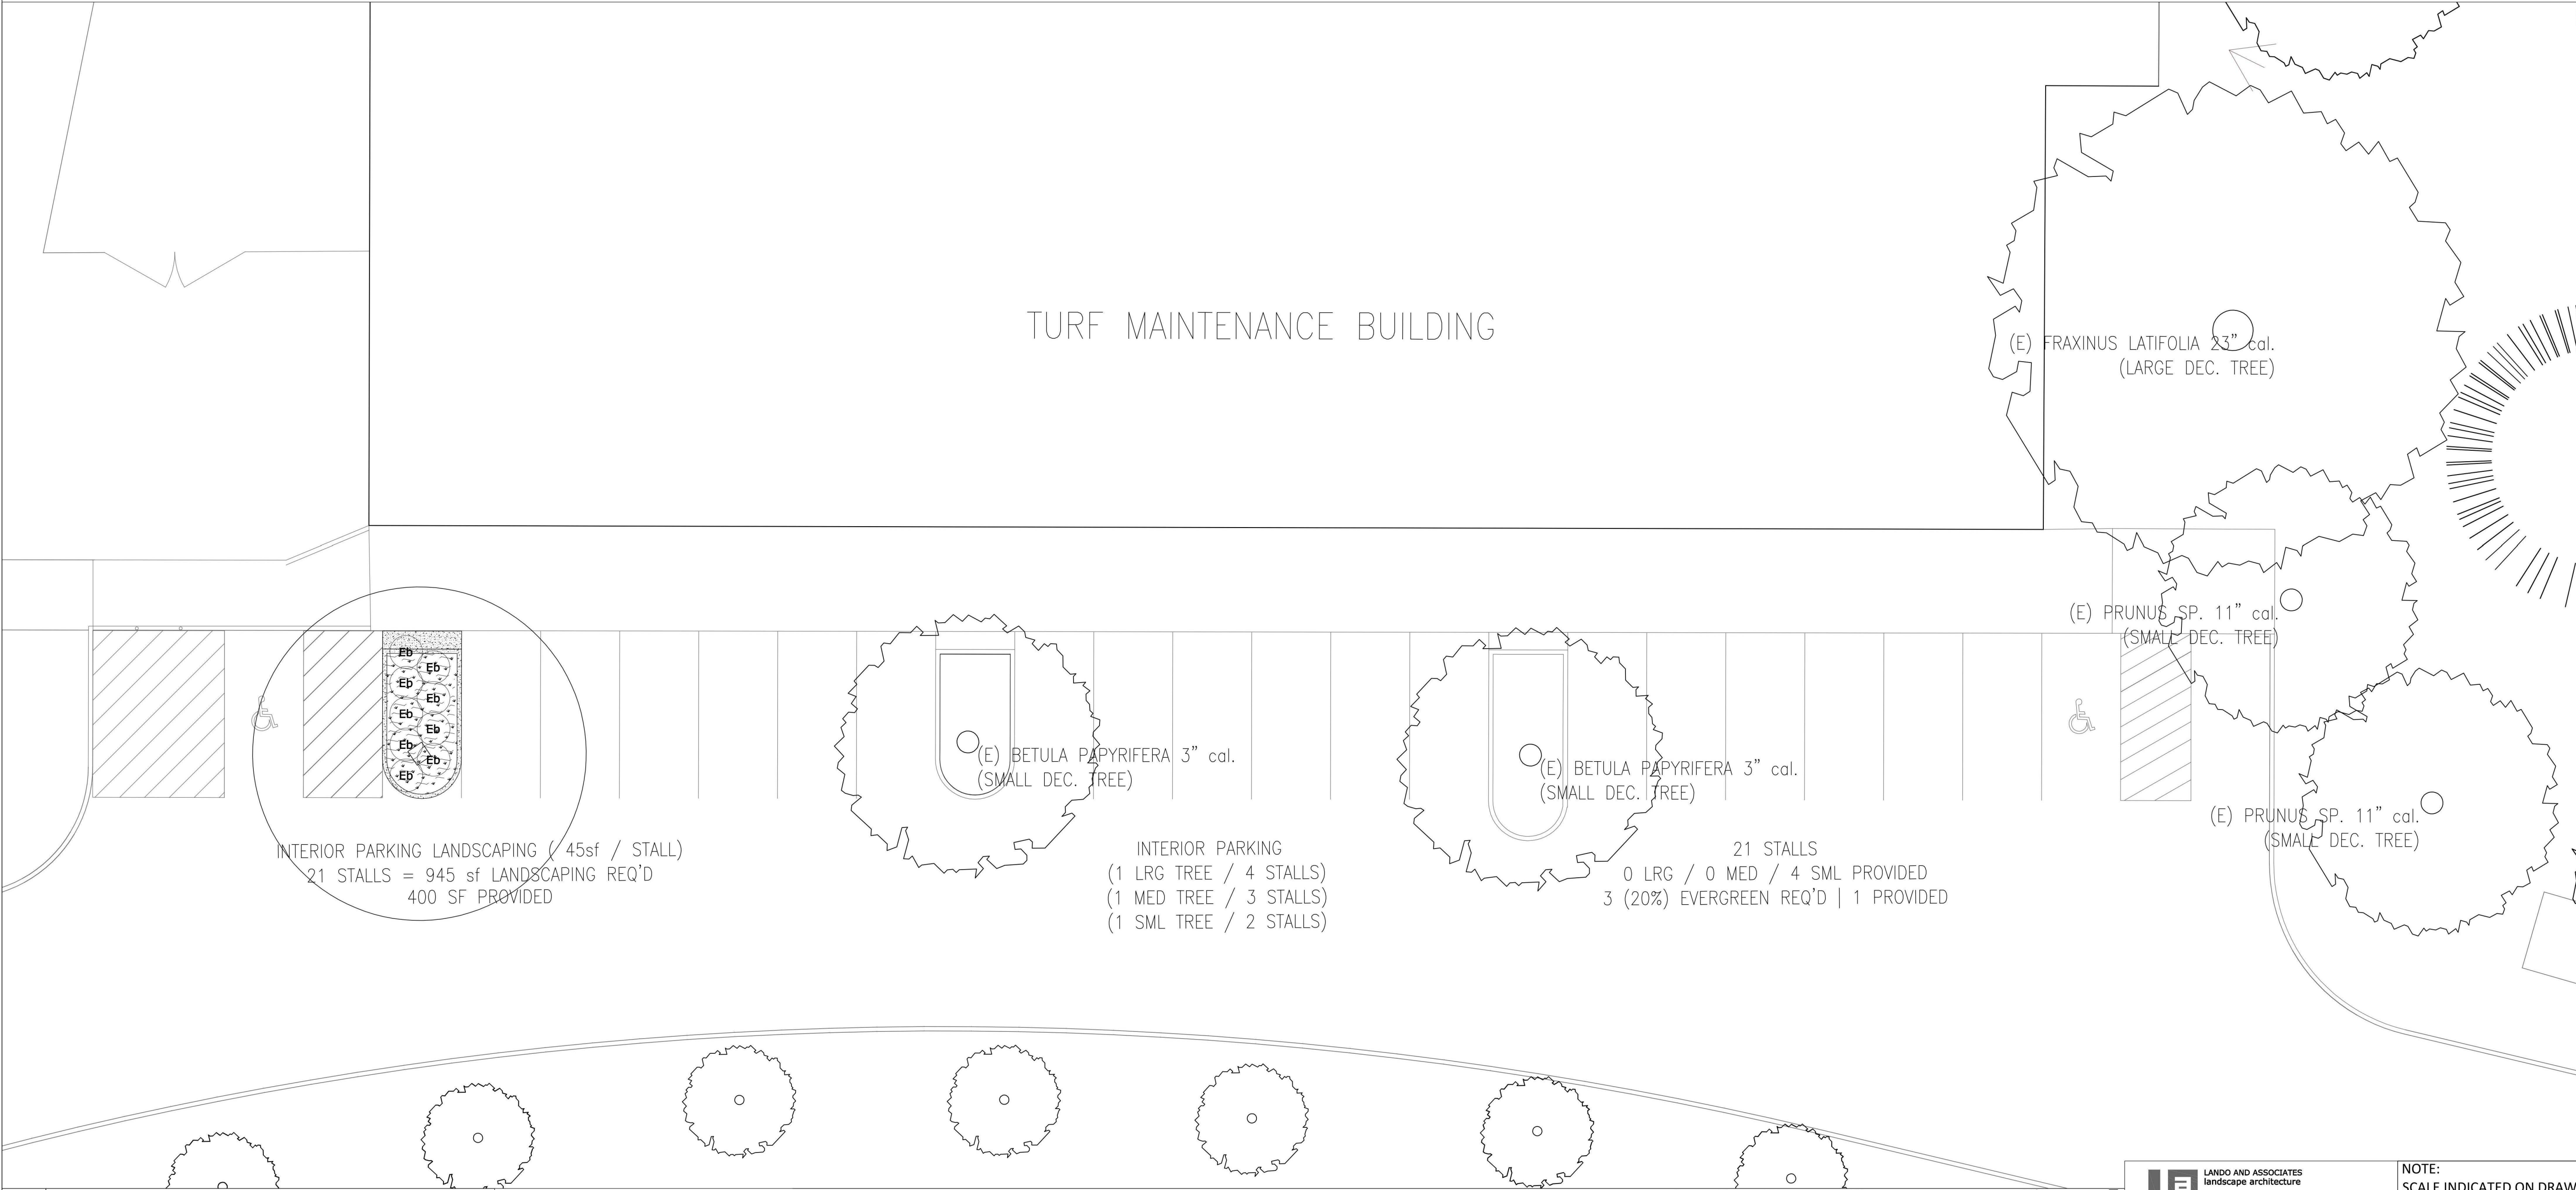

**PORTLAND
PARKS & RECREATION**

Healthy Parks, Healthy Portland

503.525.9511
www.opsisarch.com
820 NORTHWEST SEVENTEENTH AVENUE
PORTLAND | OREGON | 97209
copyright 2016 opsis architecture llp
ALL RIGHTS RESERVED

PERMIT / BID SET
08.30.2018

Portland Parks and Recreation
Amanda Fritz, Commissioner Kira Selley, Intern Director

Landscape Planting Plan
Urban Forestry Maintenance Facility
PROJECT MANAGER: ROBIN LAUGHLIN
10910 N Denver, Portland, OR 97217

DATE: **10.04.2019** SCALE: DRAWN BY: **PL** SECTION:

REVISIONS		
DATE	DESCRIPTION	BY

L3-10


Job No. **4655-01**

PLOTTED FROM: \$COMPUTERNAME\$

PLOTTED BY: \$USERNAME\$

PLOTTED ON: \$DATE\$

DRAWING: \$FILE\$

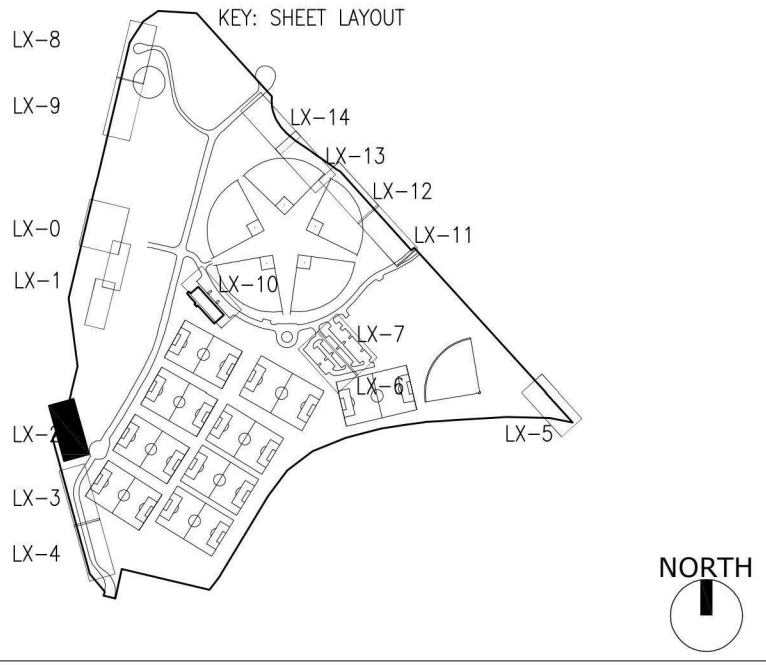


PLANT SCHEDULE — TREES			
SYMBOL	SCIENTIFIC NAME	COMMON NAME	SIZE
5	SEQUIADENDRON GIGANTEUM	GIANT SEQUOIA	3" CAL
3	THUJA PLICATA	WESTERN RED CEDAR	3" CAL

(E) EVERGREEN TREE LINE

(E) EVERGREEN TREE LINE

1 LANDSCAPE PLANTING

SCALE: 1" = 10' - 0"

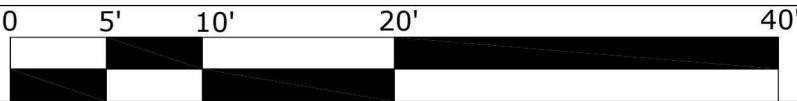

LANDO AND ASSOCIATES
landscape architecture
5607 SE SCOTT DRIVE
PORTLAND | OREGON | 97215
503.233.6600 | Lando_LandscapeArchitecture.com


NOTE:
SCALE INDICATED ON DRAWING
IS CORRECT IF DRAWING
BORDER IS 22" X 34".

PORTLAND
PARKS & RECREATION
Healthy Parks, Healthy Portland

opsis

503.525.9511
www.opsisearch.com
920 NORTHWEST SEVENTEENTH AVENUE
PORTLAND | OREGON | 97209
copyright 2016 opsis architecture llp
ALL RIGHTS RESERVED

PERMIT / BID SET
08.30.2018

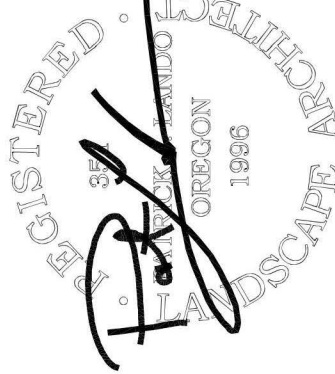

Portland Parks and Recreation

Ananda Fritz, Commissioner Kira Selley, Intern Director

Landscape Planting Plan

Urban Forestry Maintenance Facility

PROJECT MANAGER: ROBIN LAUGHLIN

DATE: 10.04.2019

SCALE:

DRAWN BY: PL

SECTION:


REVISIONS

DATE	DESCRIPTION	BY
REV #1		



L3-2

Job No.
4655-01

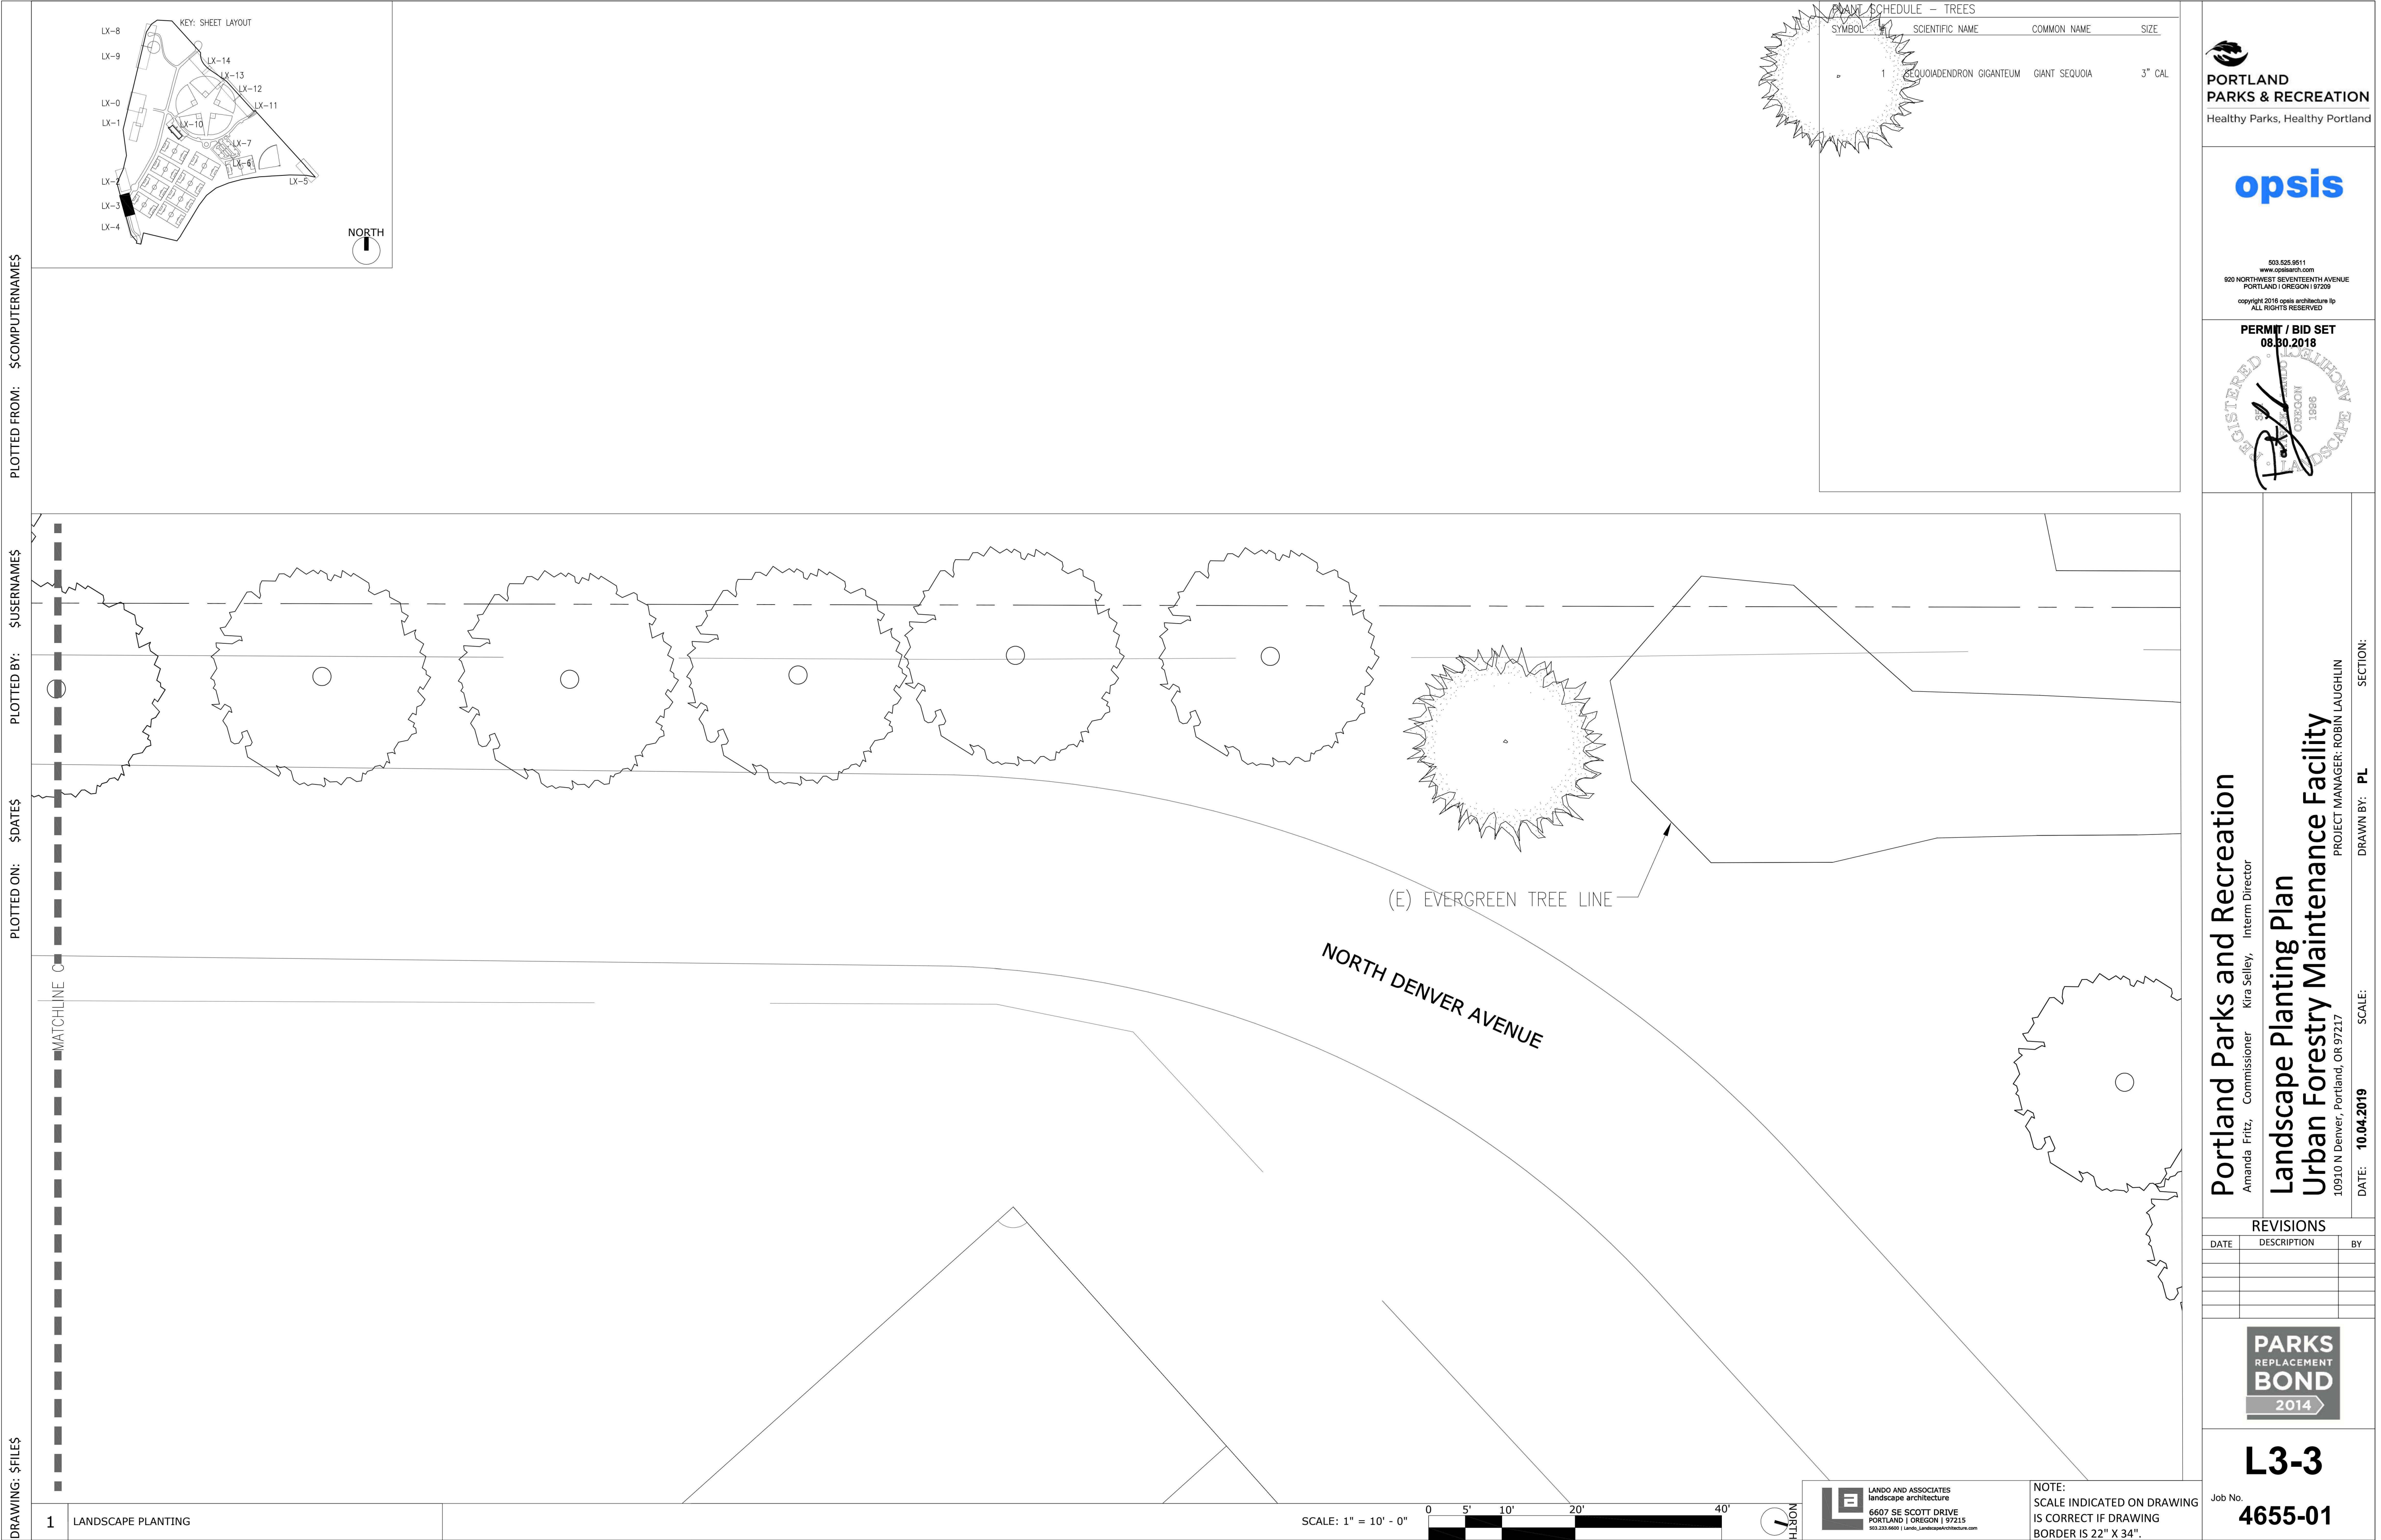


PLOTTED FROM: \$COMPUTERNAME\$


PLOTTED BY: \$USERNAME\$

PLOTTED ON: \$DATE\$

DRAWING: \$FILE\$

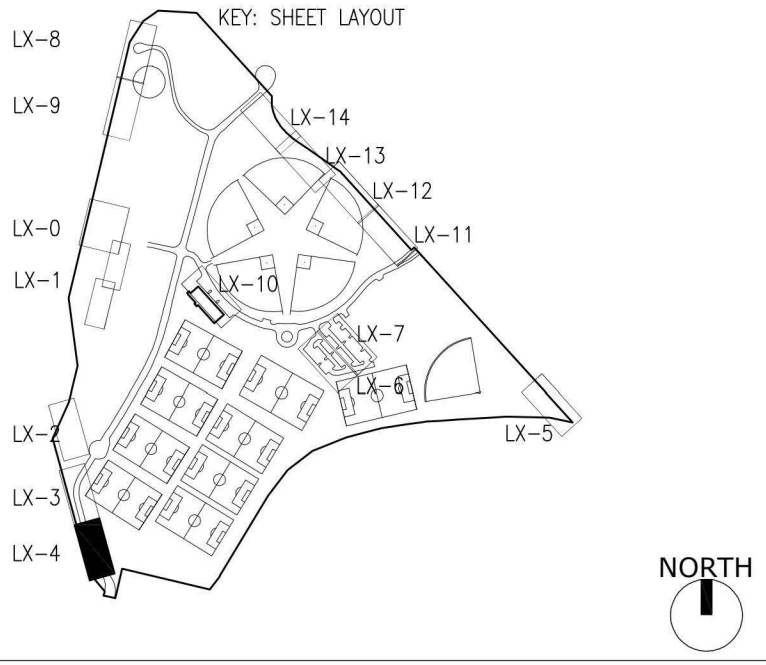

PLANTING SCHEDULE — TREES			
SYMBOL	#	SCIENTIFIC NAME	COMMON NAME SIZE
	8	THUJA PLICATA	WESTERN RED CEDAR 3" CAL

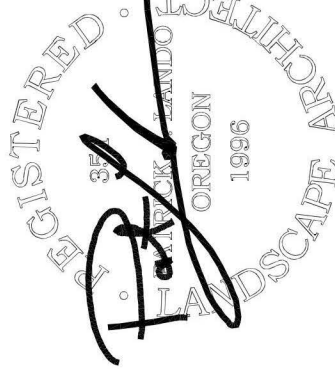

Portland Parks and Recreation

Ananda Fritz, Commissioner Kira Selley, Intern Director

Landscape Planting Plan
Urban Forestry Maintenance Facility

PROJECT MANAGER: ROBIN LAUGHLIN

DATE: **10.04.2019**

SCALE:

DRAWN BY: **PL**

SECTION:

REVISIONS

DATE	DESCRIPTION	BY



L3-4

Job No.
4655-01

NORTH DENVER AVENUE

MATCHLINE C

SCALE: 1" = 10' - 0"




PLOTTED FROM: \$COMPUTERNAME\$

PLOTTED BY: \$USERNAME\$

PLOTTED ON: \$DATE\$

DRAWING: \$FILE\$

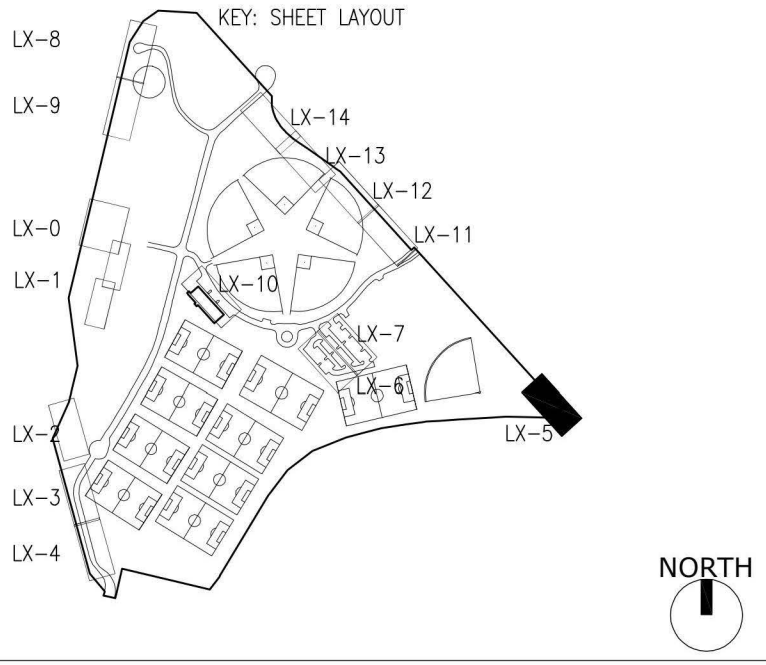


PLANT SCHEDULE — GROUND LAYER				
SYMBOL	#	SCIENTIFIC NAME	COMMON NAME	SIZE
PLANT MIX B1 — 12" O.C.				
	60%	ARCTOSTAPHYLOS UVA URSI	KINNICKINNICK	4" POT
	20%	FRAGARIA VIRGINIANA	WILD STRAWBERRY	4" POT
	10%	GAULTHERIA SHALLON	SALAL	1 GAL
	10%	MAHONIA NERVOSA 'COMPACTA'	LOW OREGON GRAPE	1 gal


**PORTLAND
PARKS & RECREATION**
Healthy Parks, Healthy Portland

opsis

503.525.9511
www.opsisarch.com
820 NORTHWEST SEVENTEENTH AVENUE
PORTLAND | OREGON | 97209
copyright 2016 opsis architecture llp
ALL RIGHTS RESERVED

PERMIT / BID SET
08.30.2018

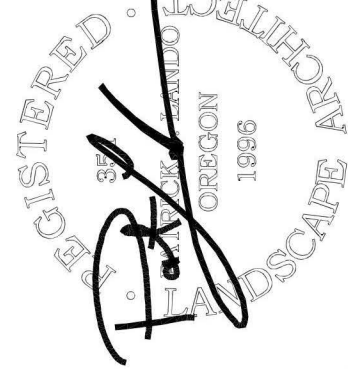

Portland Parks and Recreation

Ananda Fritz, Commissioner Kira Selley, Intern Director

Landscape Planting Plan
Urban Forestry Maintenance Facility

10910 N Denver, Portland, OR 97217
PROJECT MANAGER: ROBIN LAUGHLIN

DATE: 10.04.2019 SCALE: DRAWN BY: PL SECTION:


REVISIONS

DATE	DESCRIPTION	BY




L3-5

Job No.
4655-01

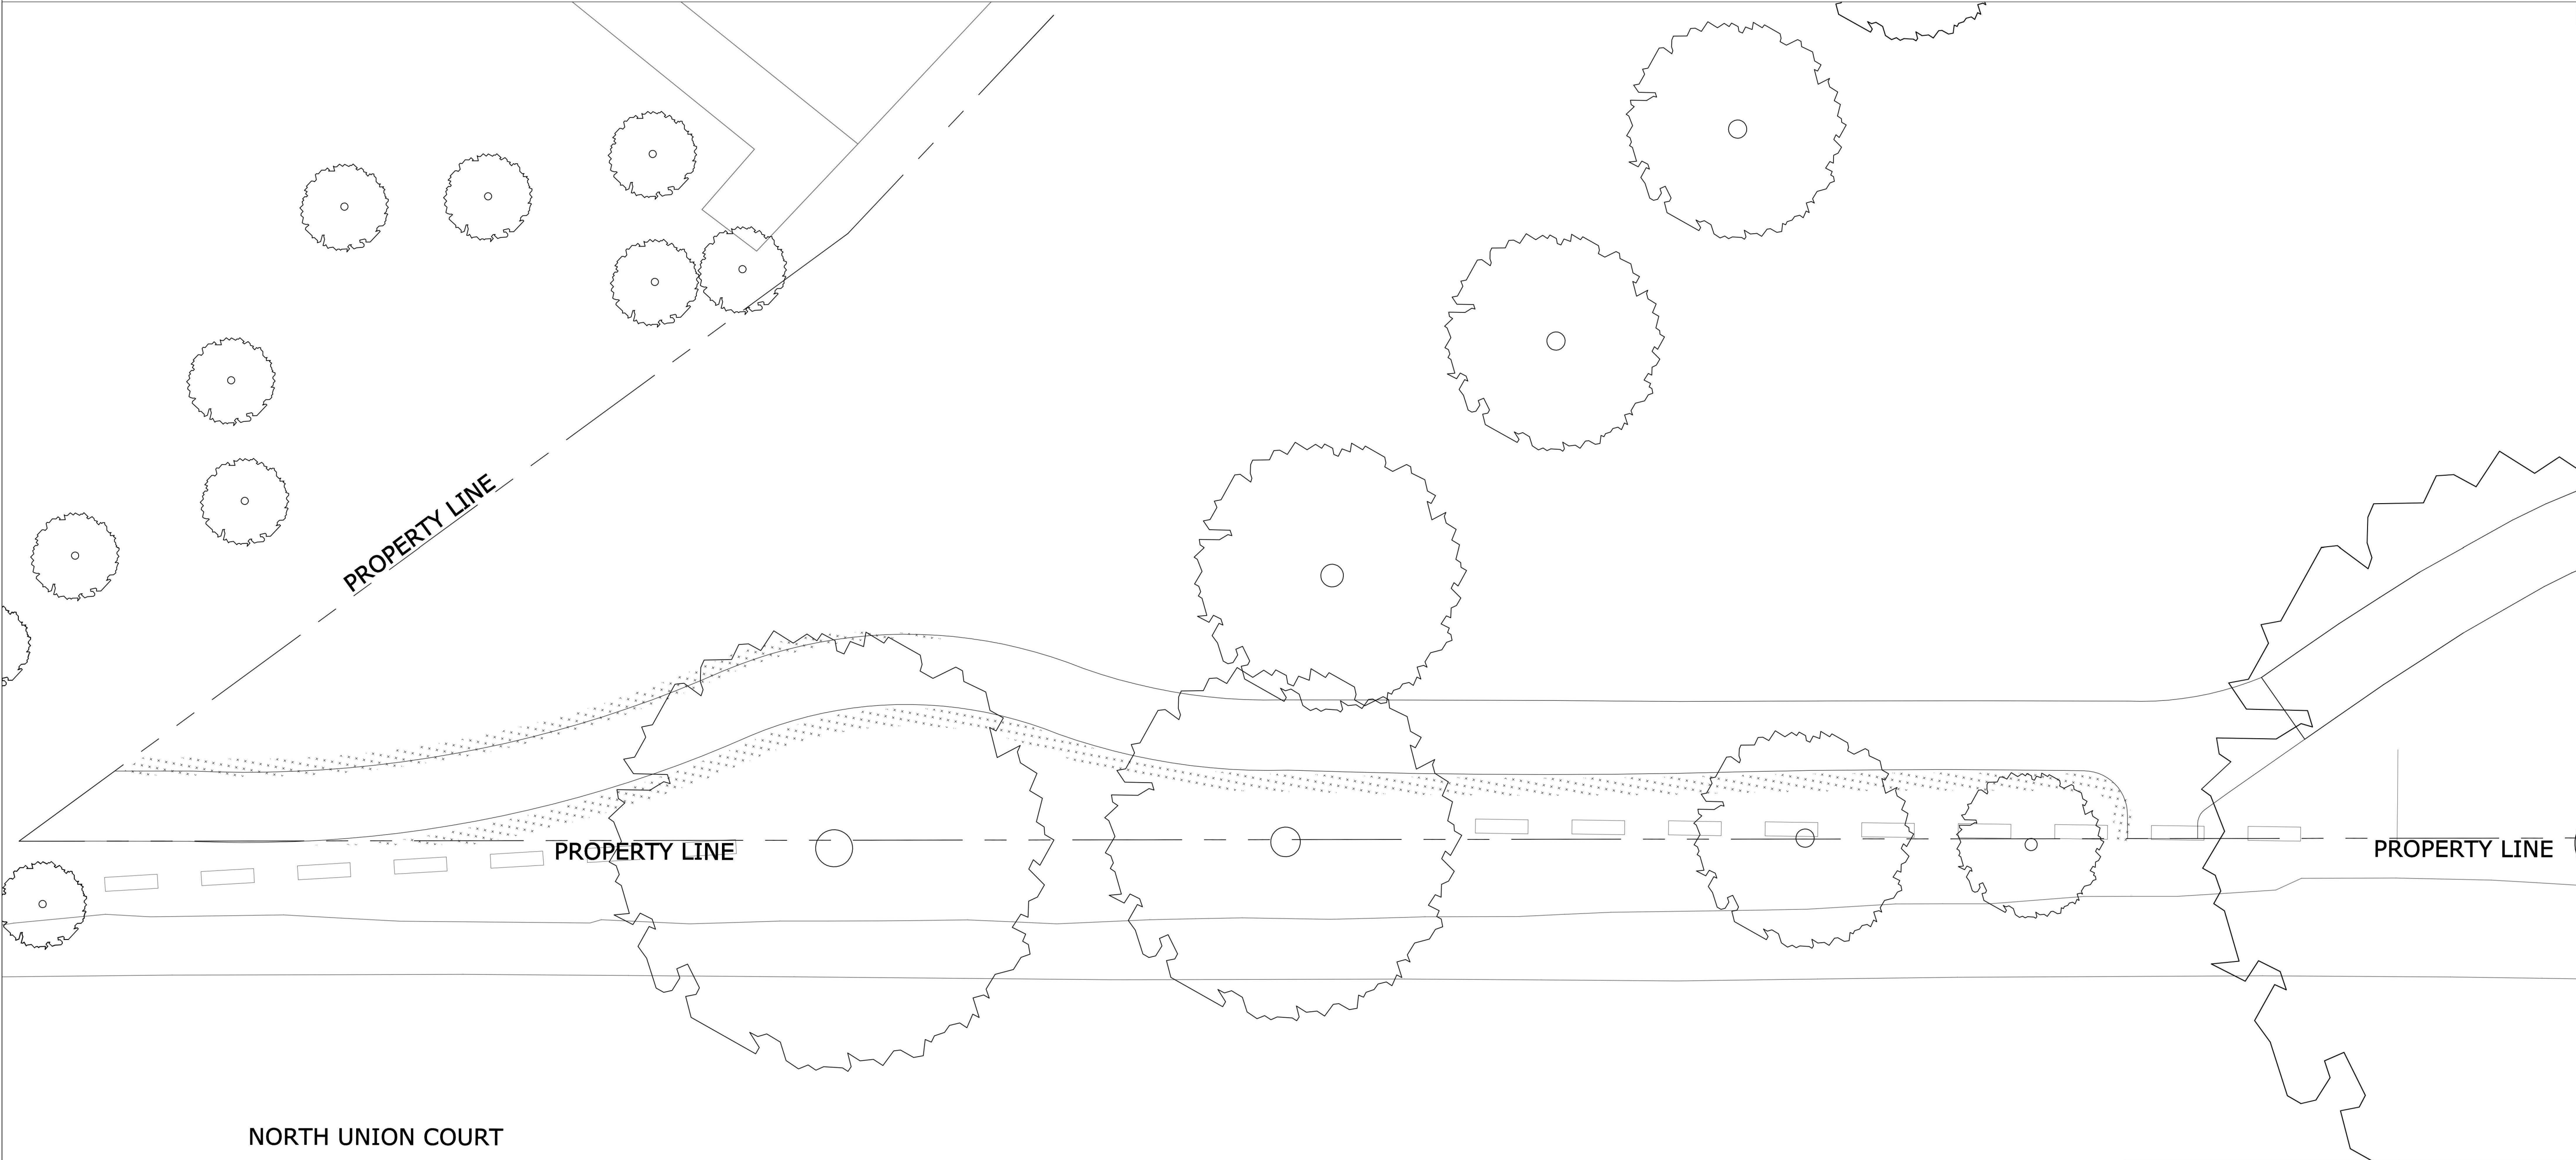

1 LANDSCAPE PLANTING

SCALE: 1" = 10' - 0"

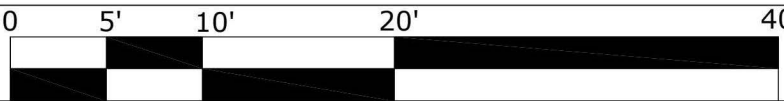

 LANDO AND ASSOCIATES
landscape architecture
5607 SE SCOTT DRIVE
PORTLAND | OREGON | 97215
503.231.6600 | Lando_LandscapeArchitecture.com


NOTE:
SCALE INDICATED ON DRAWING
IS CORRECT IF DRAWING
BORDER IS 22" X 34".

PLOTTED FROM: \$COMPUTERNAME\$

PLOTTED BY: \$USERNAME\$

PLOTTED ON: \$DATE\$

DRAWING: \$FILE\$

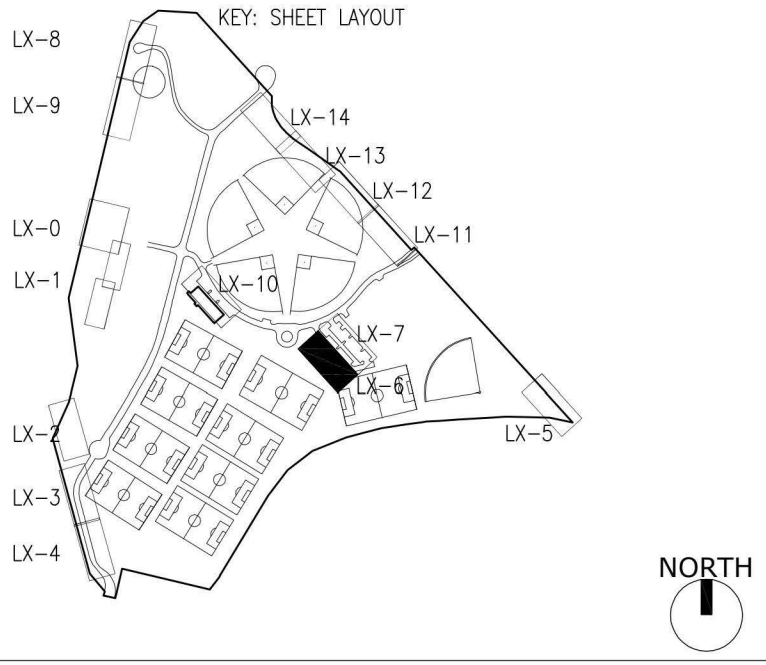


PLANT SCHEDULE – SHRUBS				
SYMBOL		SCIENTIFIC NAME	COMMON NAME	SIZE
	5	CHAMAECYPARIS OBTUSA	HINKI CYPRESS	6–7FT
	46	COR. STOLONIFERA 'OCCID.'	RED–OSIER DOGWOOD	3 gal
	51	SPIREA JAP. ALBA	JAP. WHITE SPIREA	3 gal
PLANT SCHEDULE – GROUND LAYER				
SYMBOL	#	SCIENTIFIC NAME	COMMON NAME	SIZE
		PLANT MIX A1: STORMWATER SWALE @ PARKING LOT – 12" O.C.		
	903	CAREX OBNUPA	SLOUGH SEDGE	4" POTS
	129	CAMASSIA QUAMASH	CAMAS	4" POTS
		DESCHAMPSIA CESPITOSA	TUFTED HAIRGRASS	SEED
	129	IRIS DOUGLASIANA	DOUGLAS IRIS	4" POTS
	129	LIRIOPE SPICATA	SPREADING LIRIOPE	1 GAL
		EXISTING SHRUB MASSING		

**PORTLAND
PARKS & RECREATION**
Healthy Parks, Healthy Portland

opsis

503.525.9511
www.opsisearch.com
820 NORTHWEST SEVENTEENTH AVENUE
PORTLAND | OREGON | 97209
copyright 2016 opsis architecture llp
ALL RIGHTS RESERVED

PERMIT / BID SET
08.30.2018

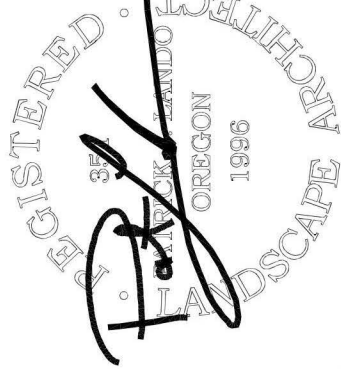

Portland Parks and Recreation

Ananda Fritz, Commissioner Kira Selley, Interm Director

Landscape Planting Plan
Urban Forestry Maintenance Facility

PROJECT MANAGER: ROBIN LAUGHLIN

DATE: 10.04.2019 SCALE: DRAWN BY: PL SECTION:


REVISIONS

DATE	DESCRIPTION	BY




L3-6

Job No.
4655-01

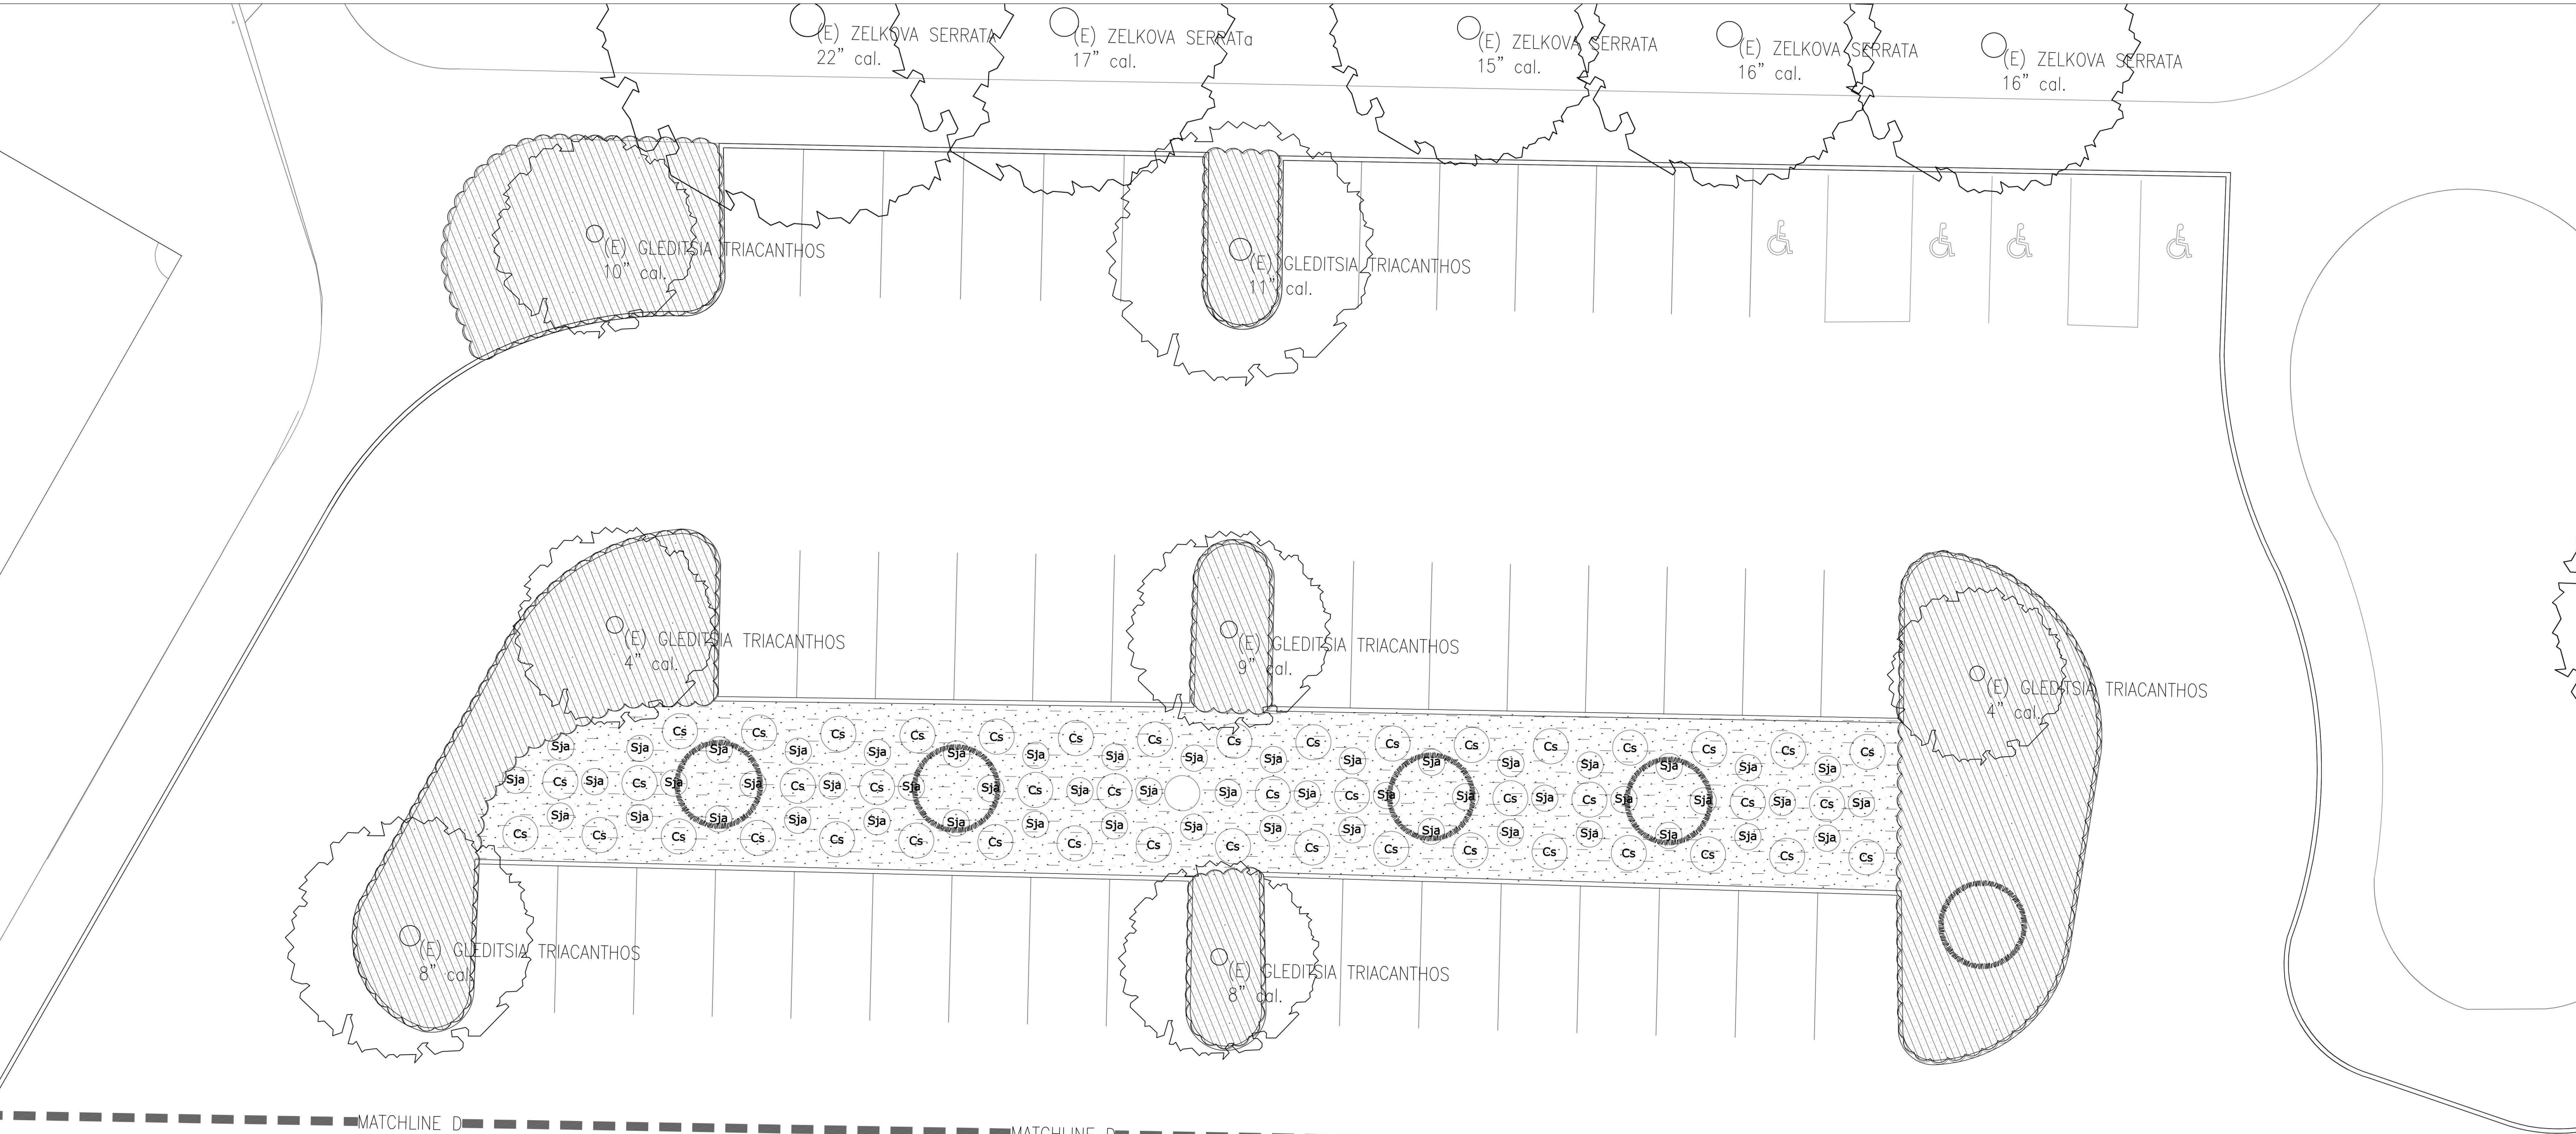

MATCHLINE D
INTERIOR PARKING LANDSCAPING (45sf / STALL)
114 STALLS = 5130 sf LANDSCAPING REQ'D
MATCHLINE D

SCALE: 1" = 10' - 0"

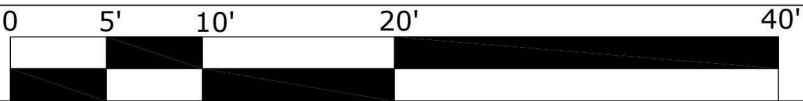

LANDO AND ASSOCIATES
landscape architecture
6607 SE SCOTT DRIVE
PORTLAND | OREGON | 97215
503.231.6600 | Lando_LandscapeArchitecture.com


NOTE:
SCALE INDICATED ON DRAWING
IS CORRECT IF DRAWING
BORDER IS 22" X 34".

PLOTTED FROM: \$COMPUTERNAME\$


PLOTTED BY: \$USERNAME\$

PLOTTED ON: \$DATE\$

DRAWING: \$FILE\$

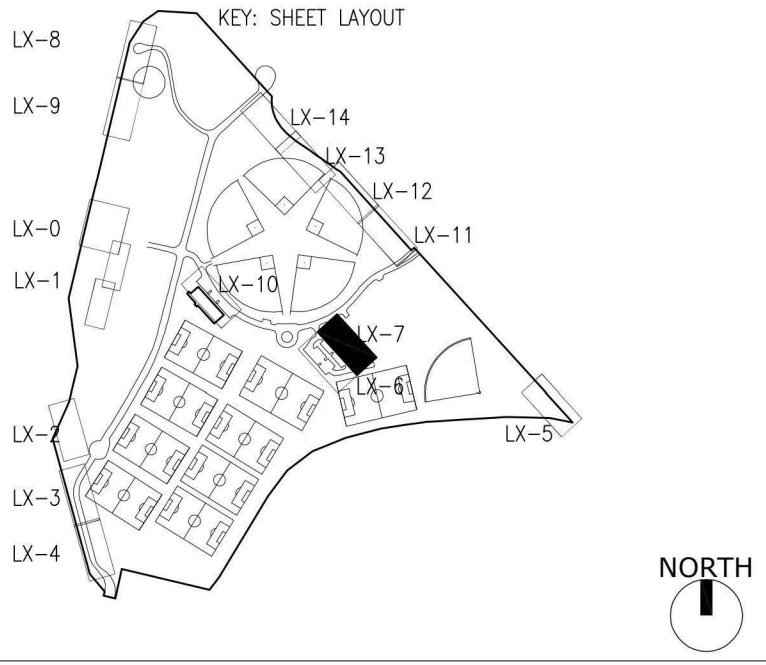

PLANT SCHEDULE — SHRUBS				
SYMBOL	#	SCIENTIFIC NAME	COMMON NAME	SIZE
Cs-2 Sxb Gs	74	COR. STOLONIFERA 'ARCTIC FIRE'	ARCTIC FIRE DOGWOOD	3 gal
	83	SPIREA X BUMALDA	GOLD FLAME SPIREA	3 gal
	74	GAULTHERIA SHALLON	SALAL	1 gal
PLANT SCHEDULE — GROUND LAYER				
SYMBOL	#	SCIENTIFIC NAME	COMMON NAME	SIZE
	PLANT MIX B1 — 12" O.C.			
	60%	ARCTOSTAPHYLOS UVA URSI	KINNICKINICK	4" POT
	20%	FRAGARIA VIRGINIANA	WILD STRAWBERRY	4" POT
	10%	GAULTHERIA SHALLON	SALAL	1 GAL
	10%	MAHONIA NERVOSA 'COMPACTA'	LOW OREGON GRAPE	1 gal
	EXISTING SHRUB MASSING			

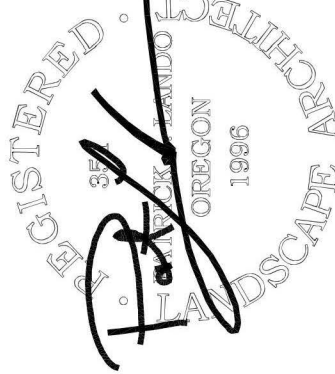

Portland Parks and Recreation

Landscaping Planting Plan
Urban Forestry Maintenance Facility

Ananda Fritz, Commissioner Kira Selley, Intern Director

PROJECT MANAGER: ROBIN LAUGHLIN

SECTION:

DRAWN BY: PL

SCALE:

DATE: 10.04.2019


REVISIONS

DATE	DESCRIPTION	BY



L3-7




Job No.
4655-01

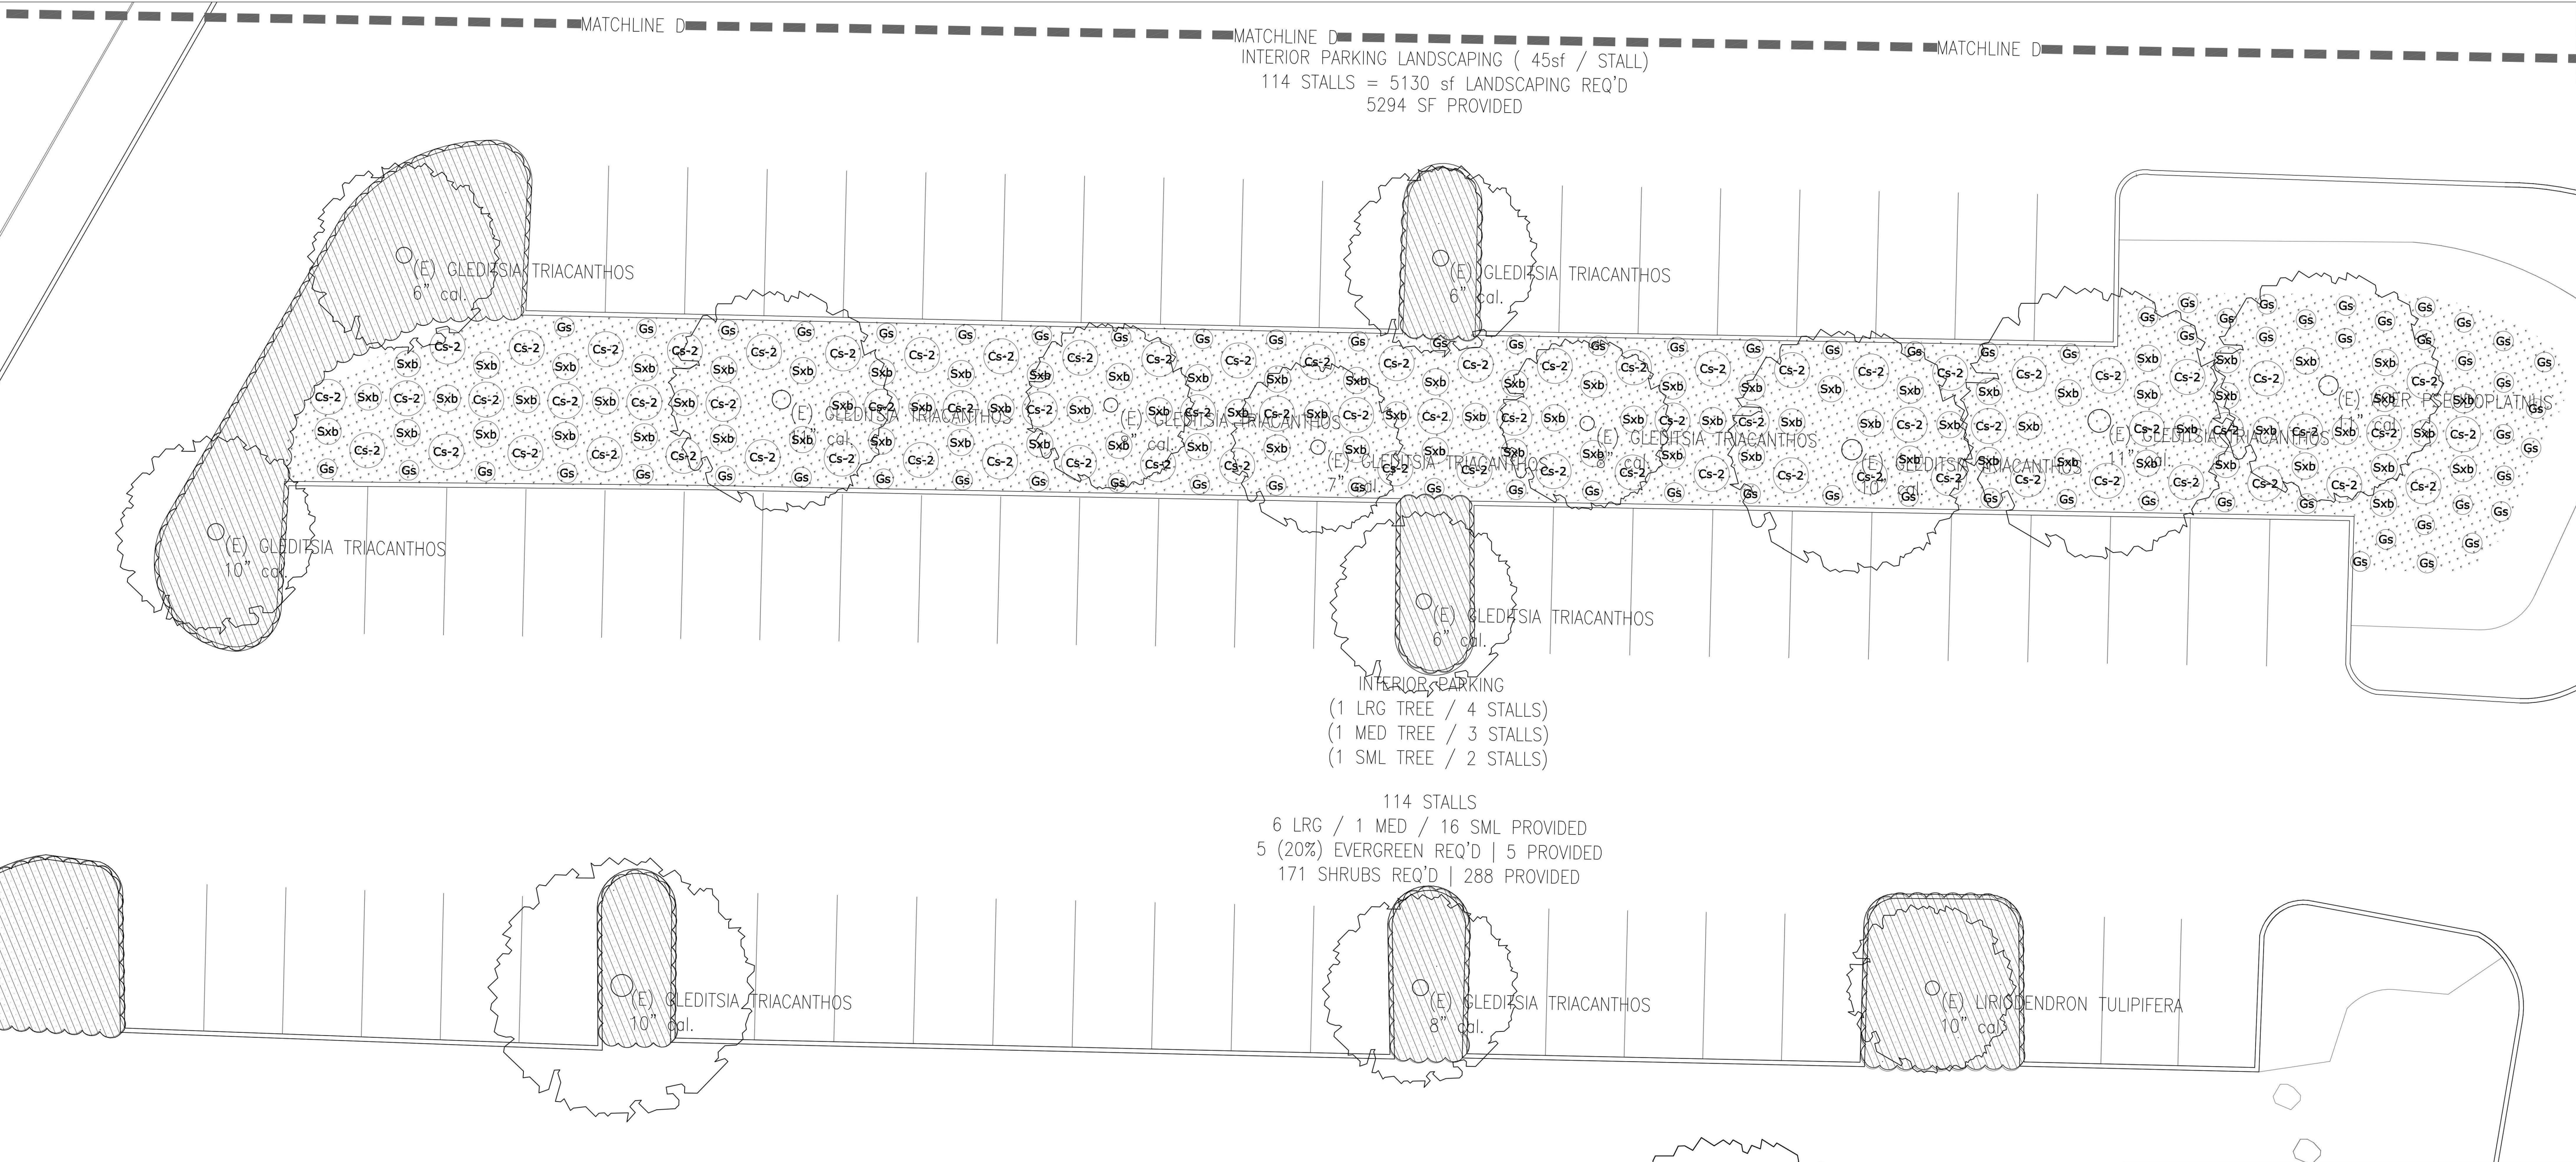

INTERIOR PARKING LANDSCAPING (45sf / STALL)
114 STALLS = 5130 sf LANDSCAPING REQ'D
5294 SF PROVIDED

INTERIOR PARKING
(1 LRG TREE / 4 STALLS)
(1 MED TREE / 3 STALLS)
(1 SML TREE / 2 STALLS)

114 STALLS
6 LRG / 1 MED / 16 SML PROVIDED
5 (20%) EVERGREEN REQ'D | 5 PROVIDED
171 SHRUBS REQ'D | 288 PROVIDED

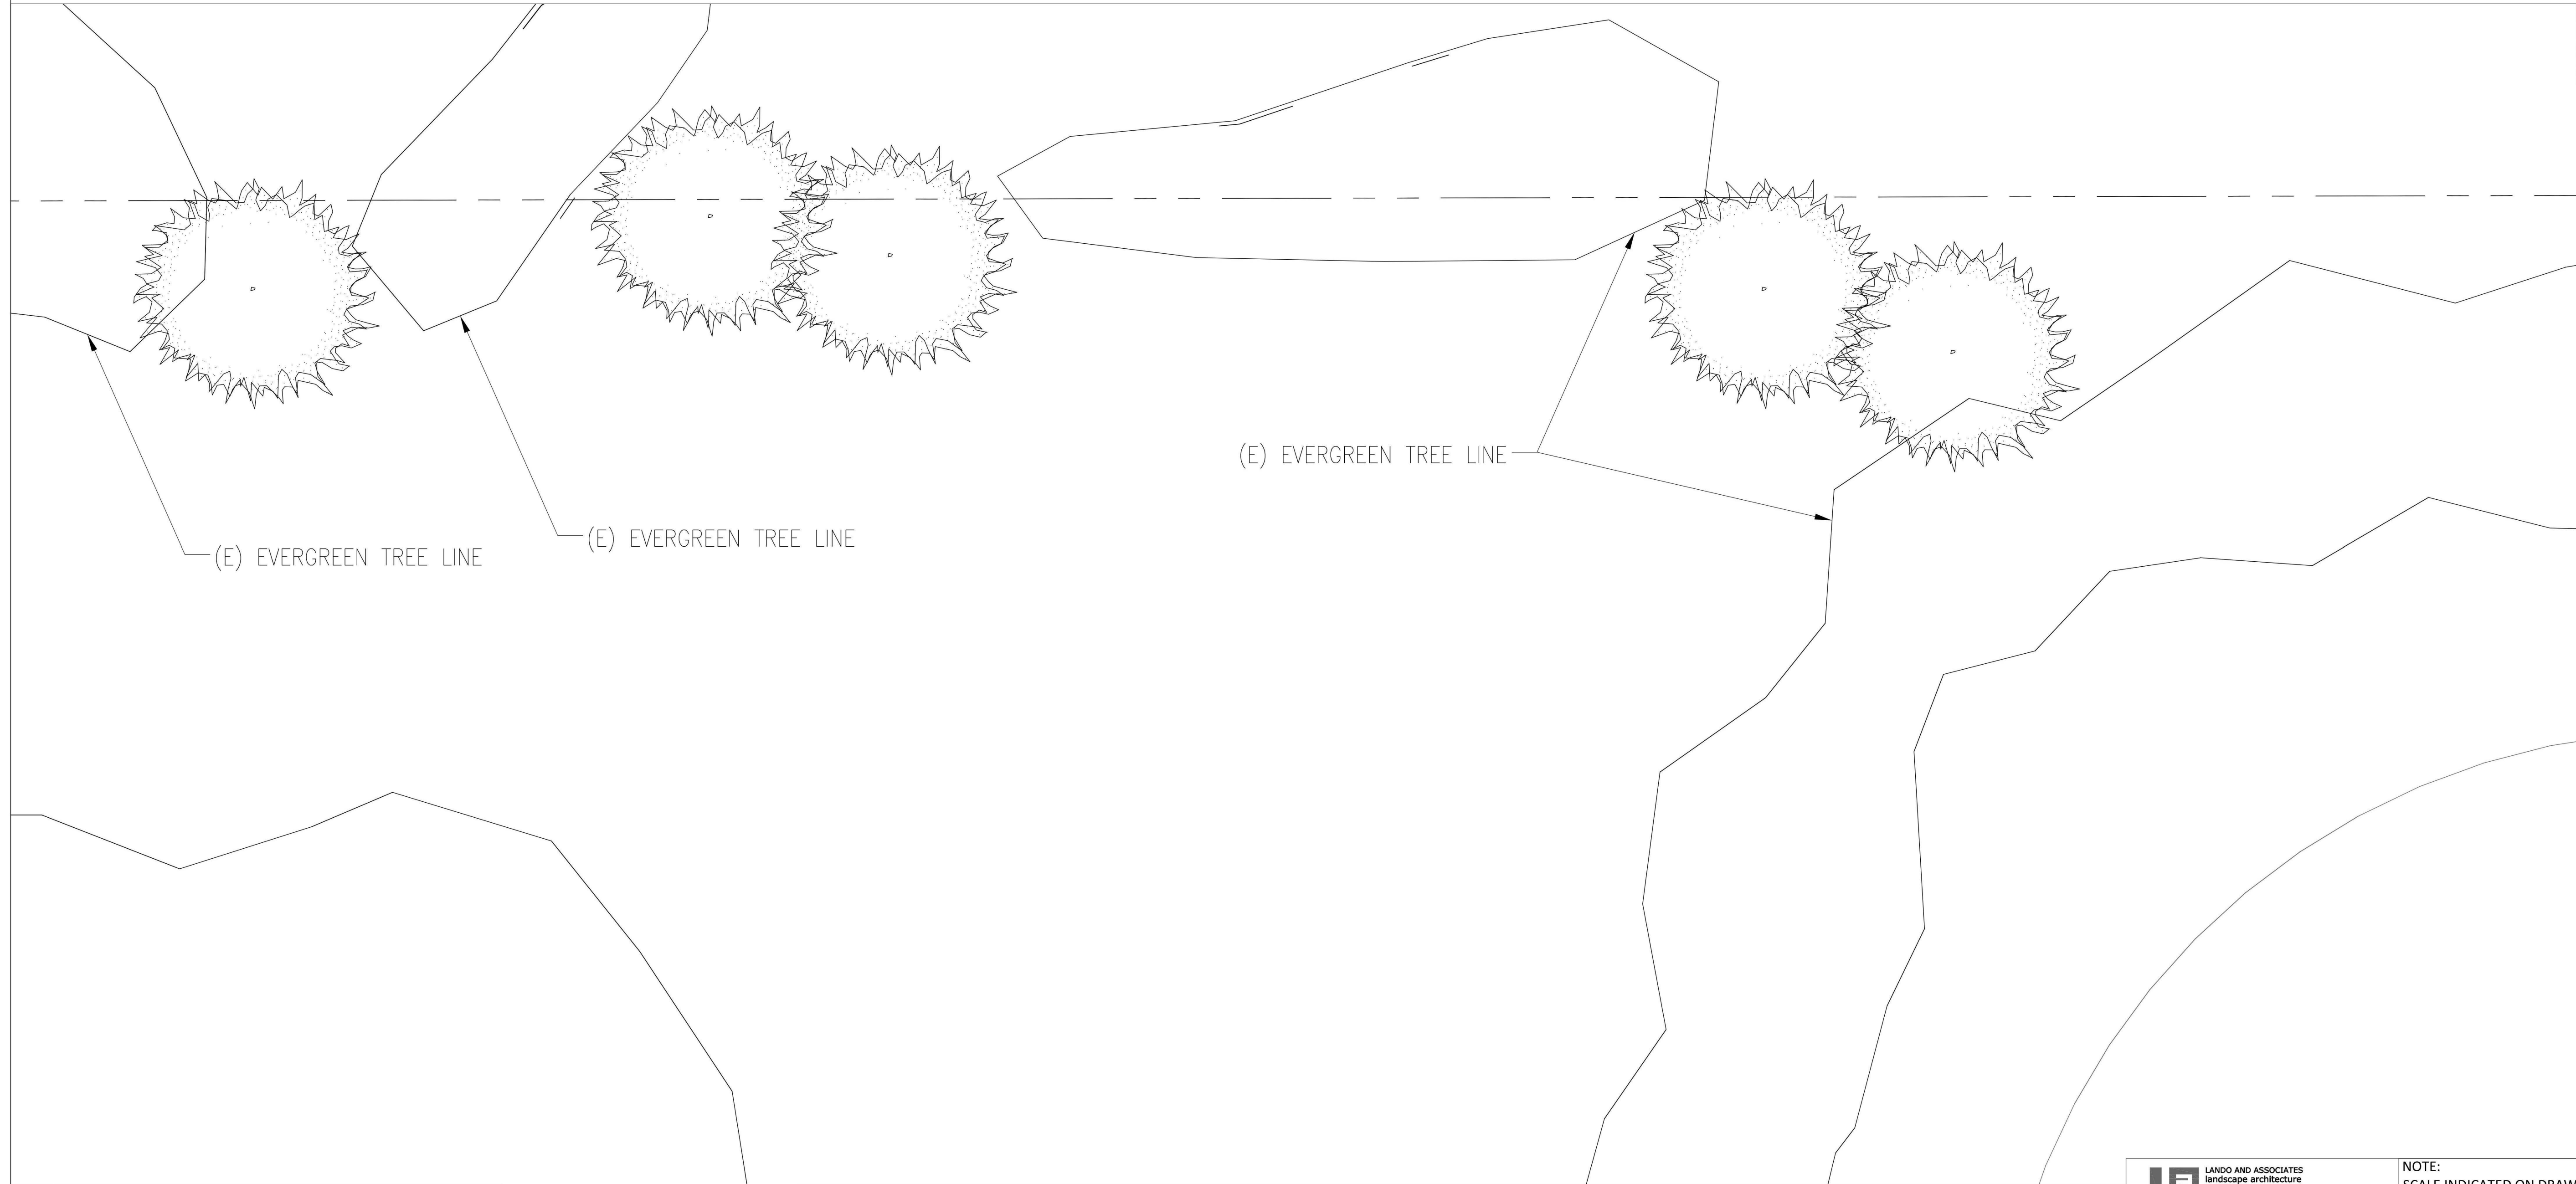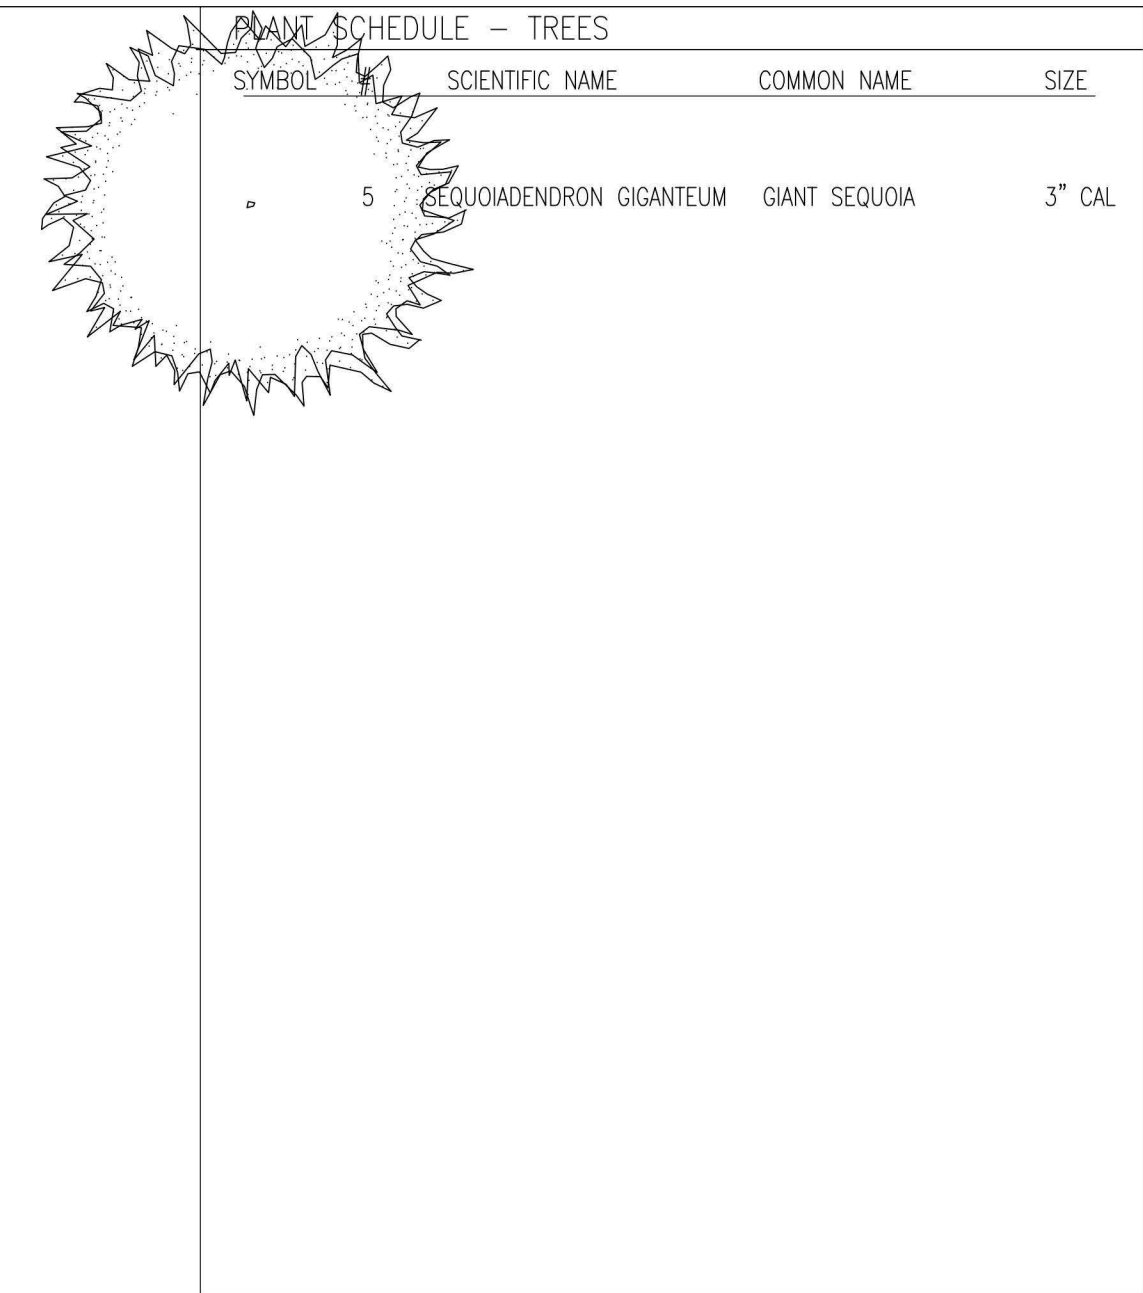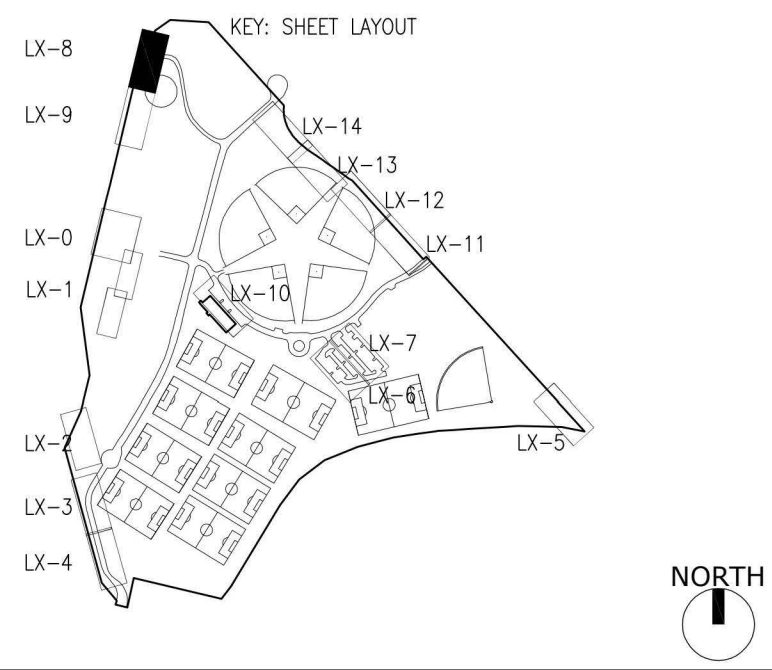

REVISIONS		
DATE	DESCRIPTION	BY



L3-8

Job No. **4655-01**

Job No.


4655-01

PLOTTED FROM: \$COMPUTERNAME\$


PLOTTED BY: \$USERNAME\$

PLOTTED ON: \$DATE\$

DRAWING: \$FILE\$

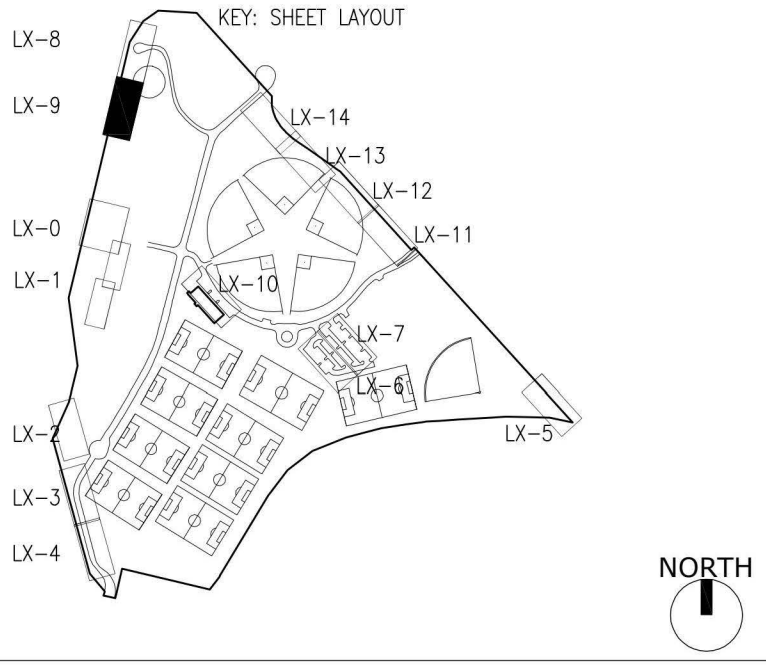

PLANT SCHEDULE — TREES			
SYMBOL	SCIENTIFIC NAME	COMMON NAME	SIZE
	SEQUIOIDENDRON GIGANTEUM	GIANT SEQUOIA	3" CAL
	THUJA PLICATA	WESTERN RED CEDAR	3" CAL

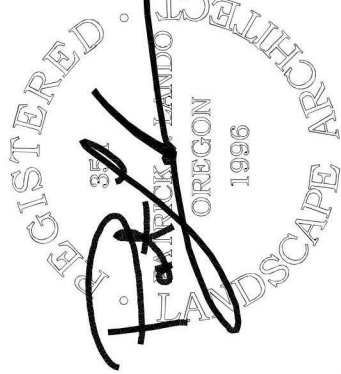

Portland Parks and Recreation

Ananda Fritz, Commissioner Kira Selley, Intern Director

**Landscape Planting Plan
Urban Forestry Maintenance Facility**

PROJECT MANAGER: ROBIN LAUGHLIN

DATE: **10.04.2019**

SCALE:

DRAWN BY: **PL**

SECTION:

REVISIONS


DATE	DESCRIPTION	BY



L3-9

Job No.


4655-01

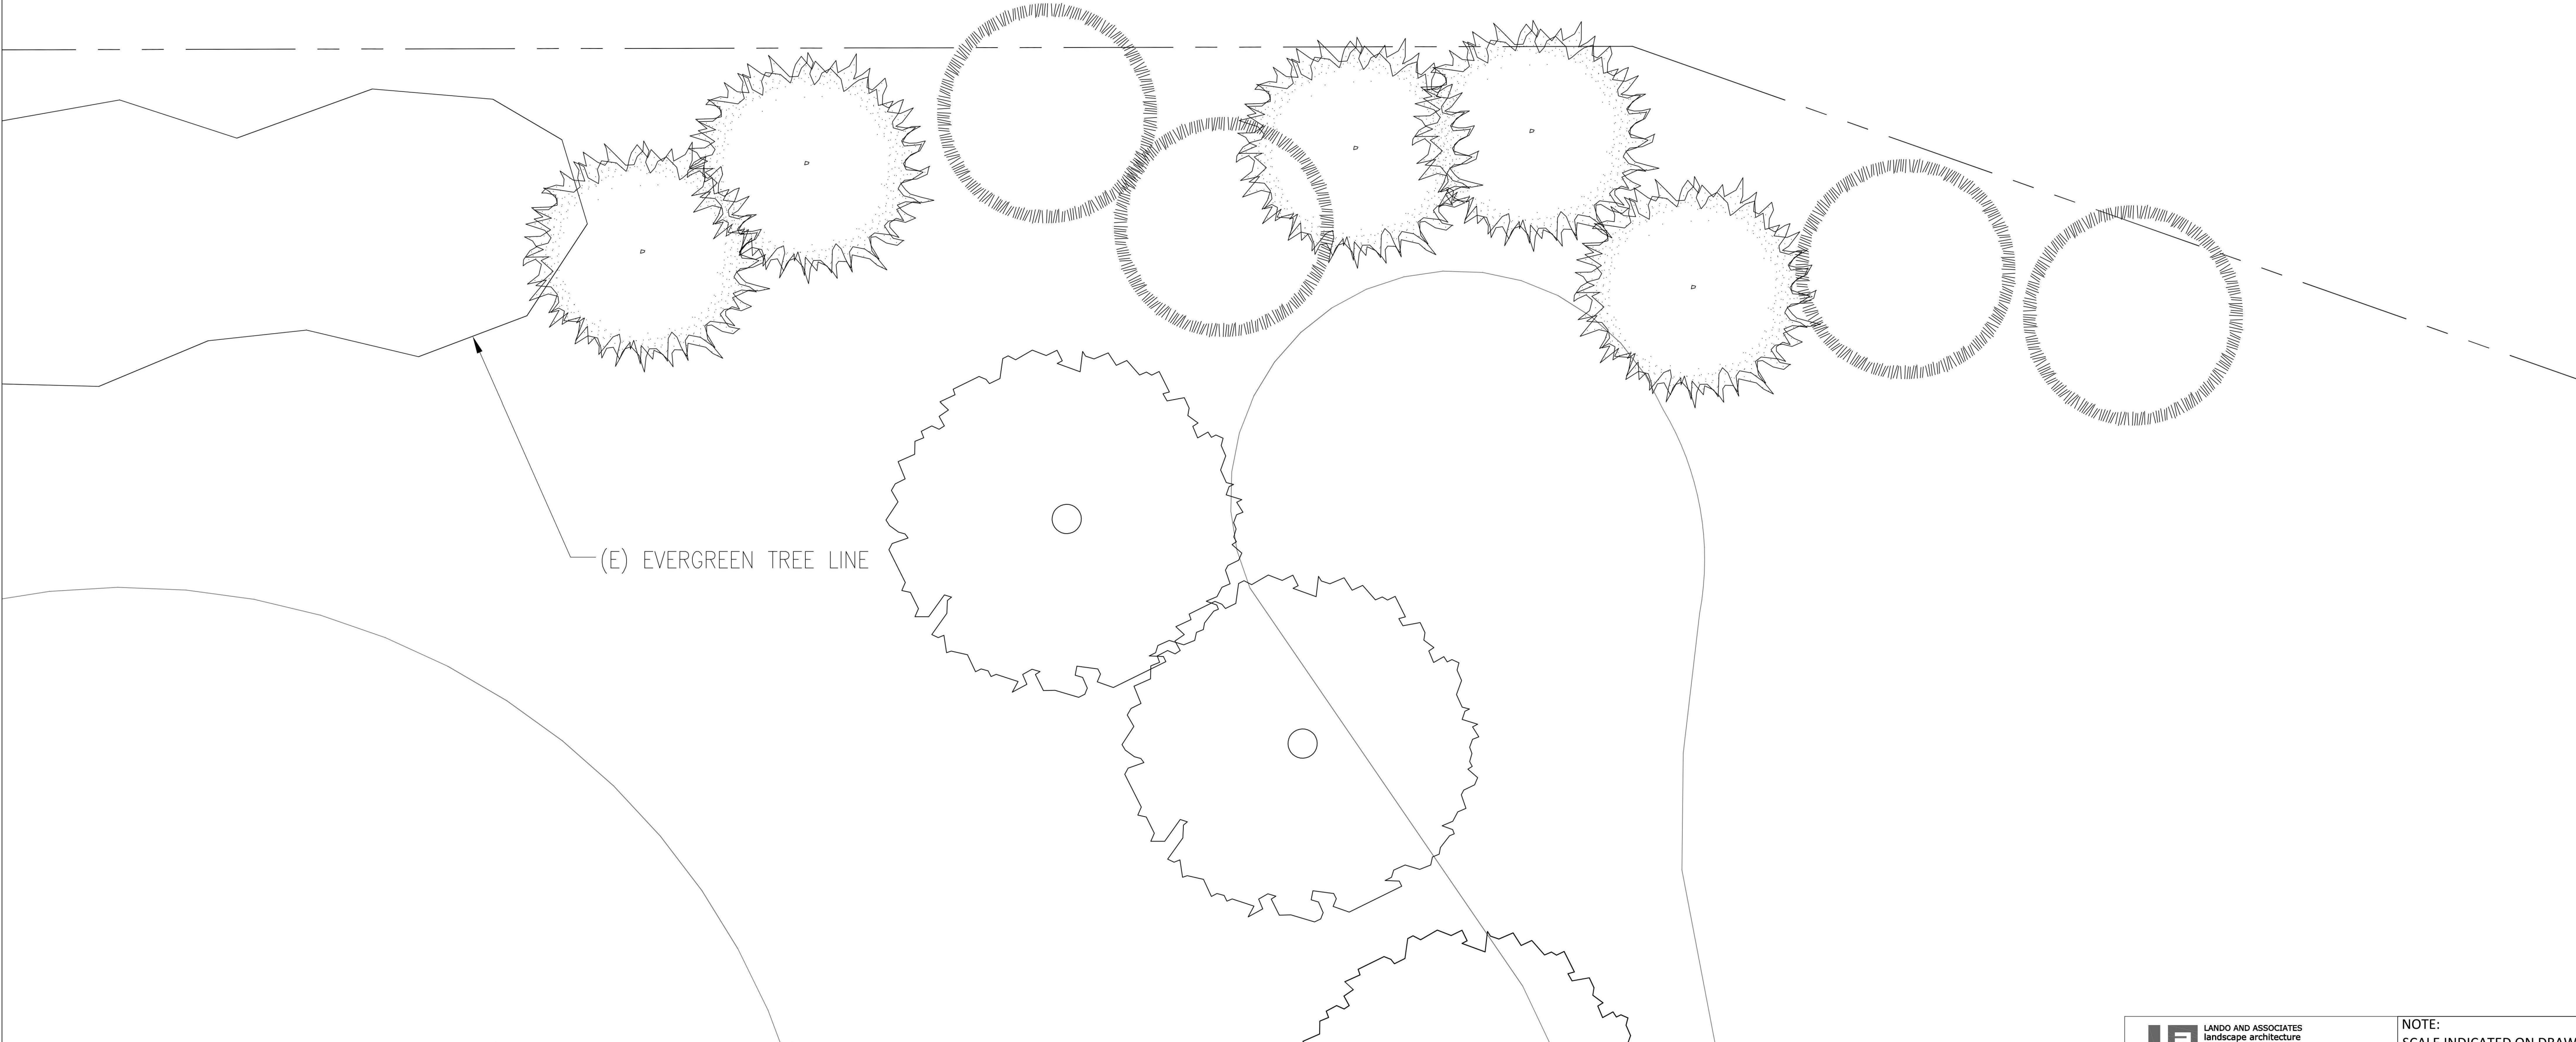

(E) EVERGREEN TREE LINE

SCALE: 1" = 10' - 0"



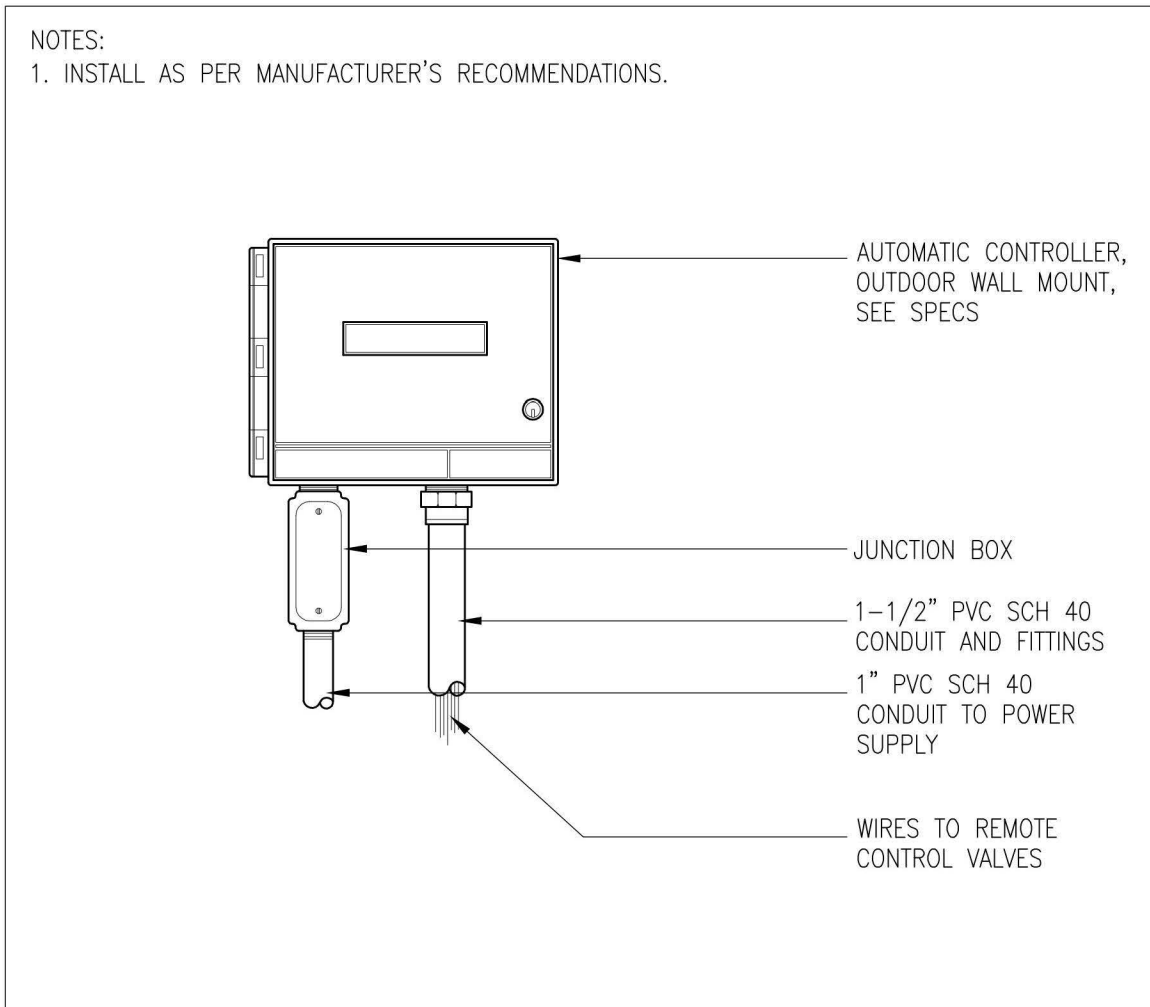


1

DETAIL: AUTOMATIC IRRIGATION CONTROLLER

CAD FILE: IRR_AC.DWG

SCALE: 1 1/2" = 1'-0"

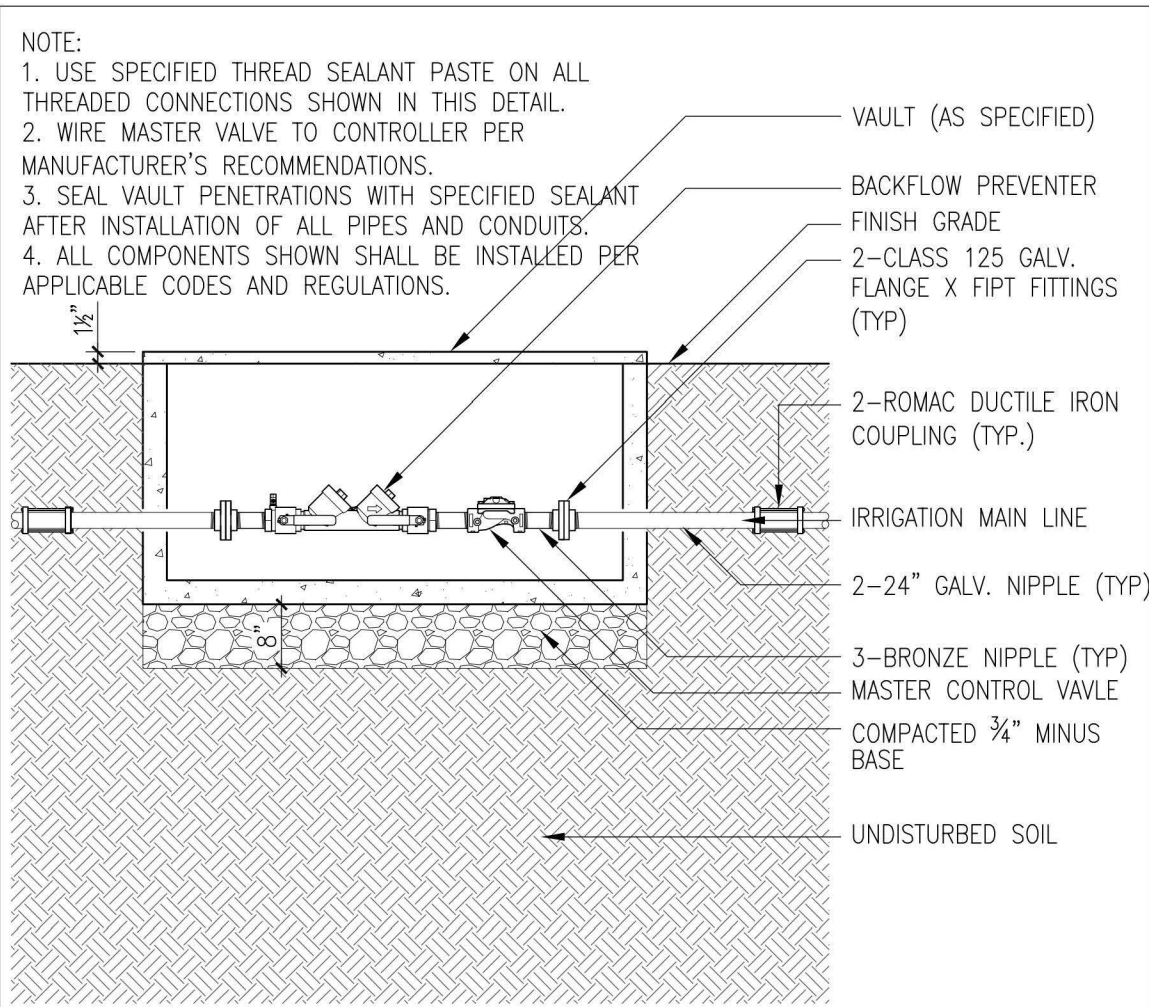


2

DETAIL: POINT OF CONNECTION

CAD FILE: D_IRR-VALVE-POC_PPR.DWG

SCALE: N.T.S.

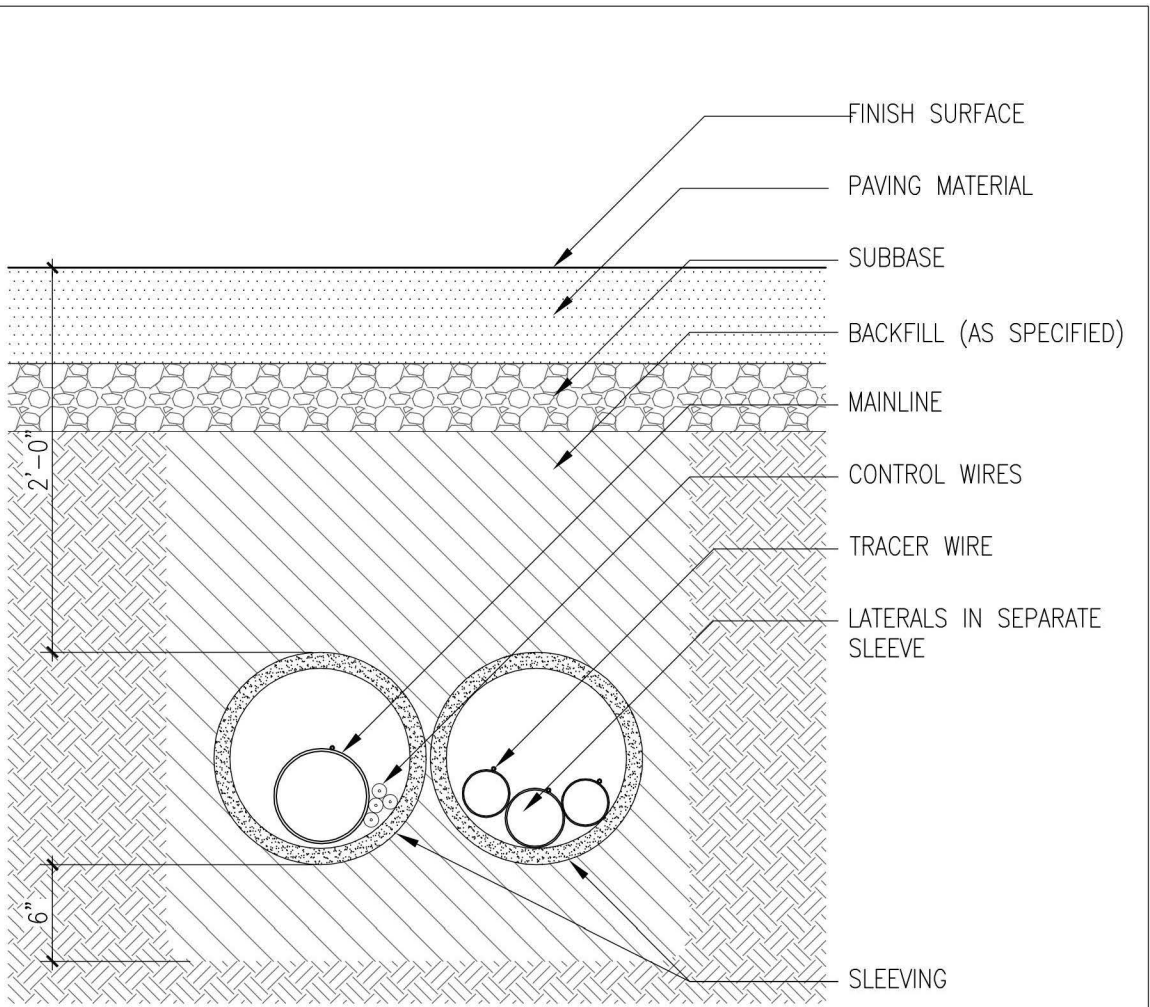


3

DETAIL: IRRIGATION SLEAVING

CAD FILE: D_IRR-SLEAVING-01.DWG

SCALE: 1" = 1'-0"

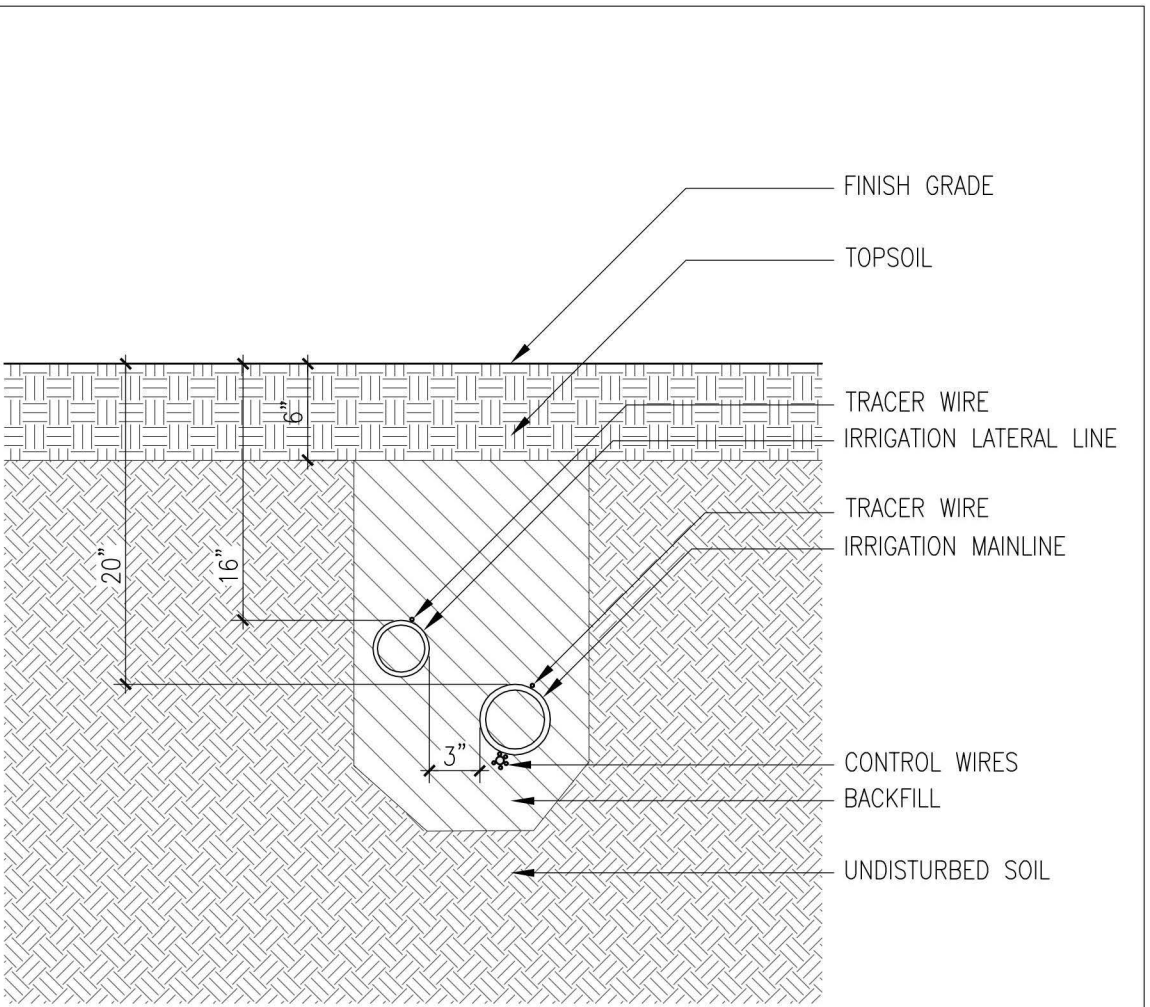


4

DETAIL: IRRIGATION TRENCHING

CAD FILE: D_IRR-TRENCHING_01.DWG

SCALE: 1" = 1'-0"

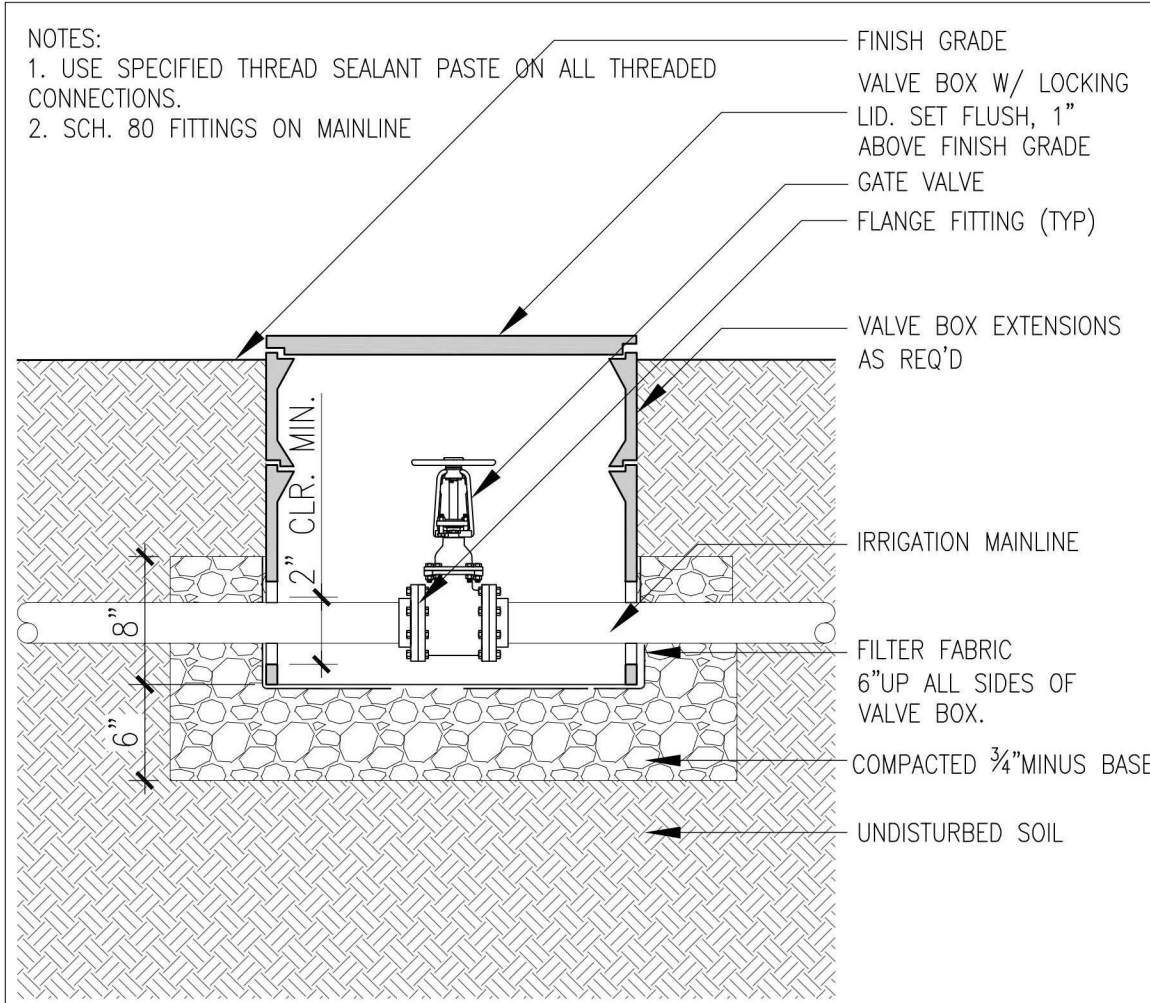


5

DETAIL: ISOLATION VALVE - LARGE

CAD FILE: D_IRR-VALVE-ISO_01.DWG

SCALE: 1" = 1'-0"

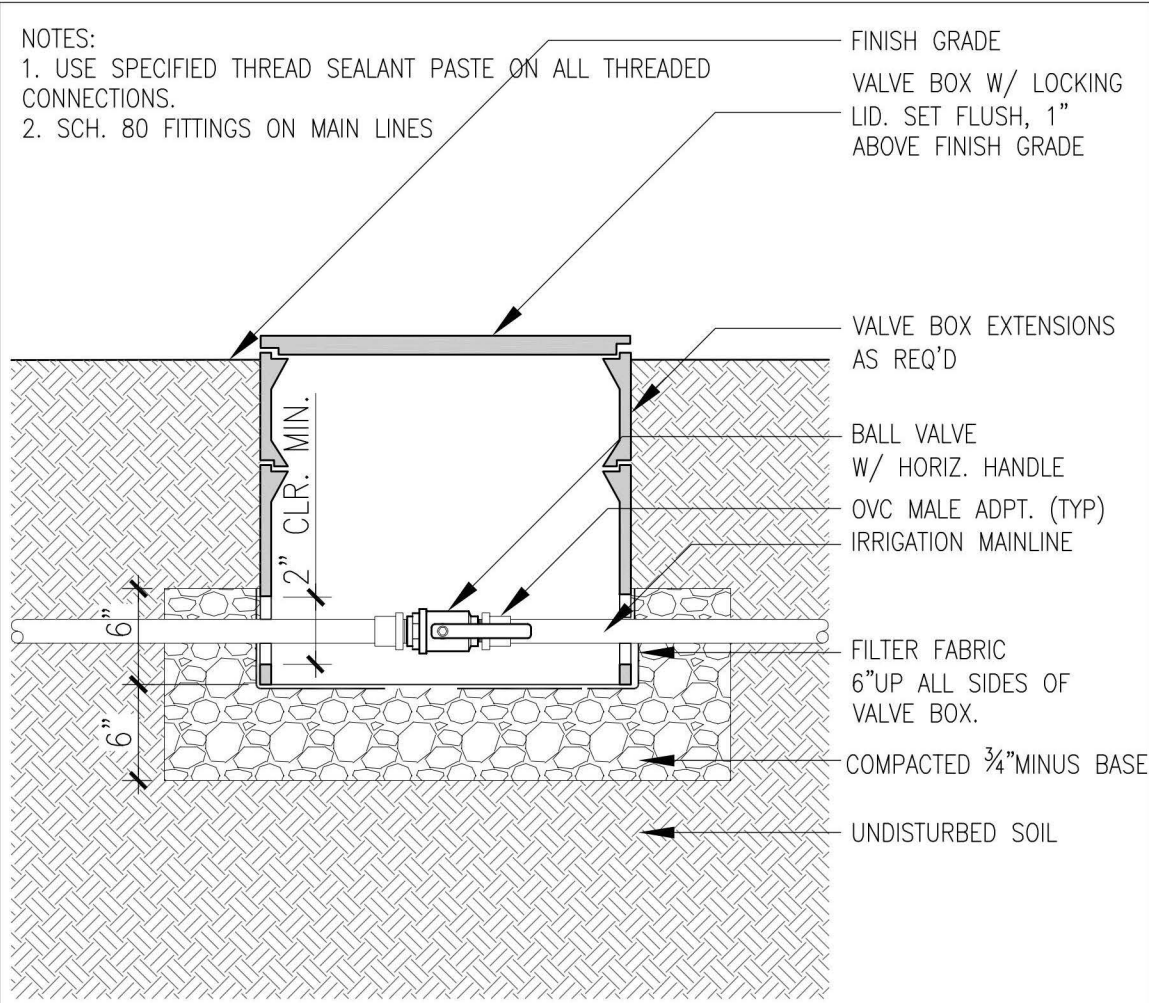


6

DETAIL: ISOLATION VALVE - SMALL

CAD FILE: D_IRR-VALVE-ISO_02.DWG

SCALE: 1" = 1'-0"

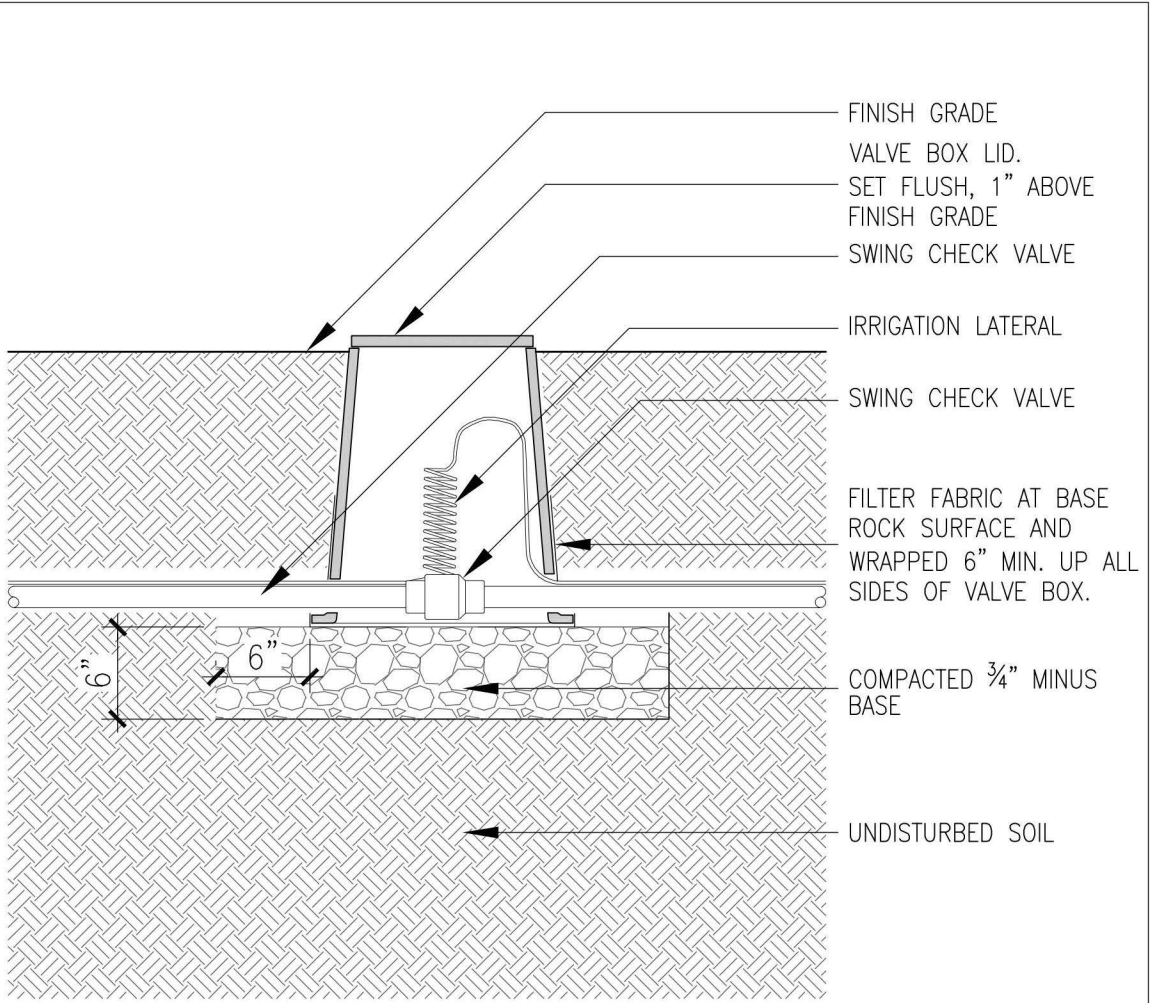


7

DETAIL: SWING CHECK VALVE

CAD FILE: D_IRR-VALVE-SWINGCHECK-01.DWG

SCALE: 1" = 1'-0"

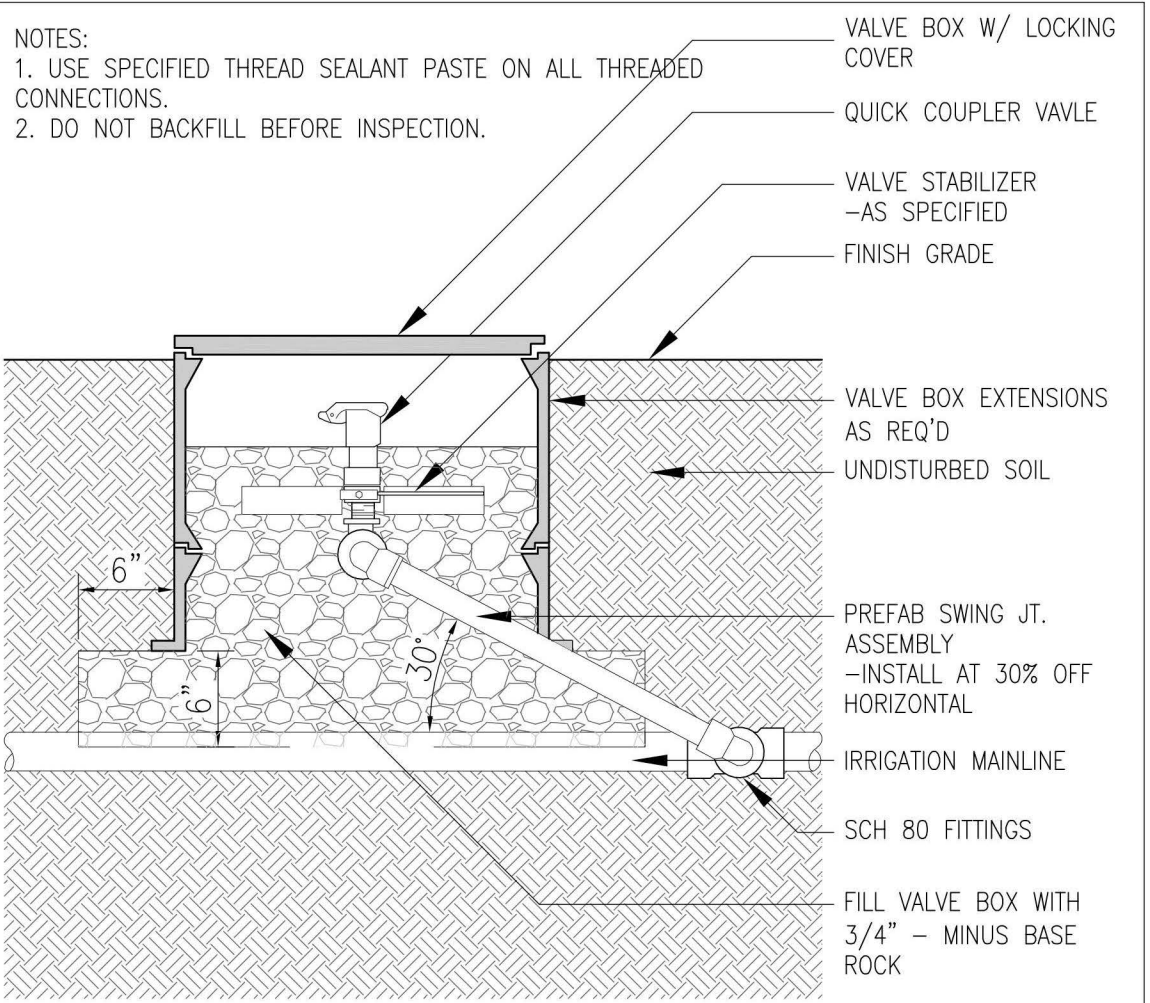


8

DETAIL: QUICK COUPLER VALVE

CAD FILE: IRR_VALVE-QCV_01.DWG

SCALE: N.T.S.

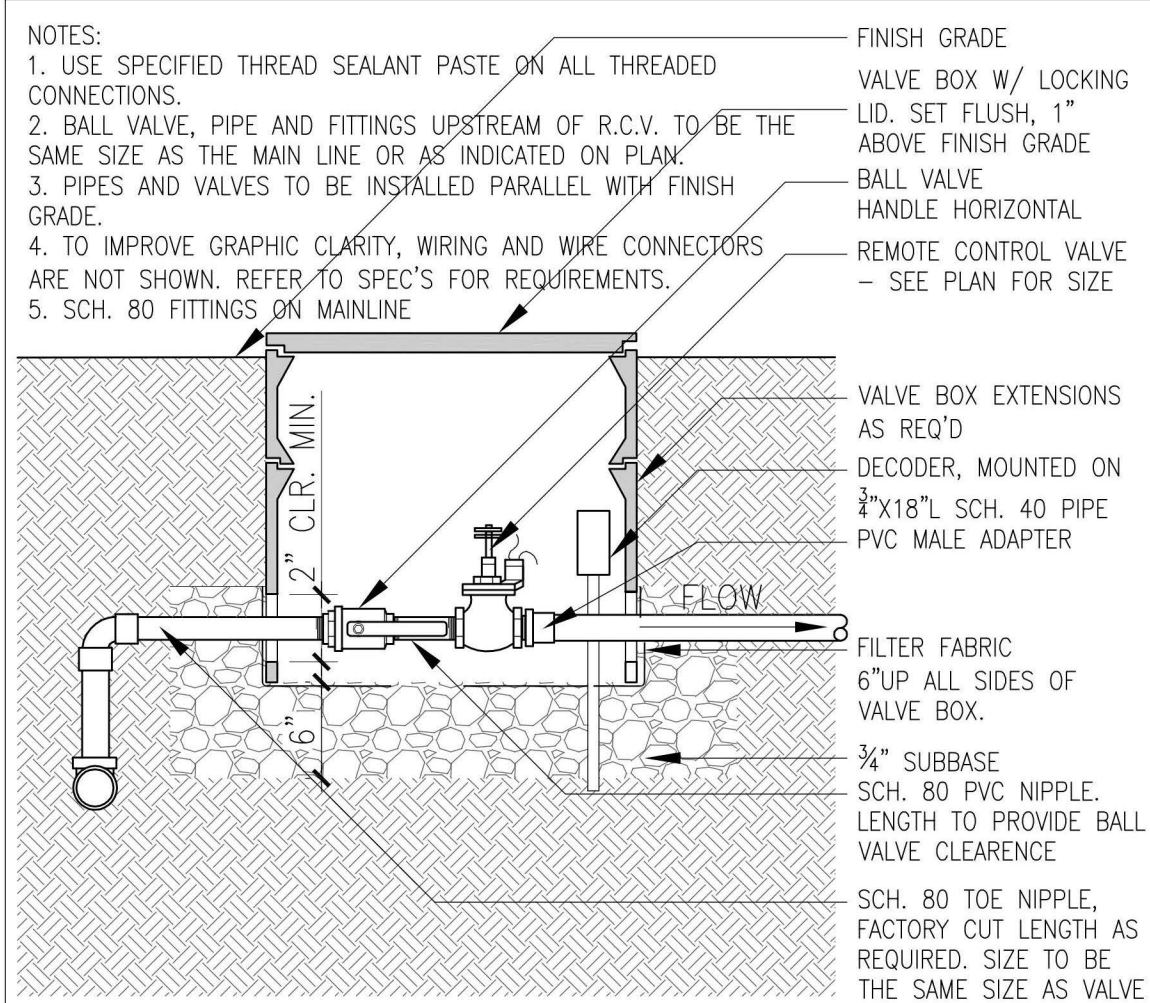


9

DETAIL: REMOTE CONTROL VALVE

CAD FILE: IRR_VALVE-REMOTE-STND.DWG

SCALE: 1" = 1'-0"

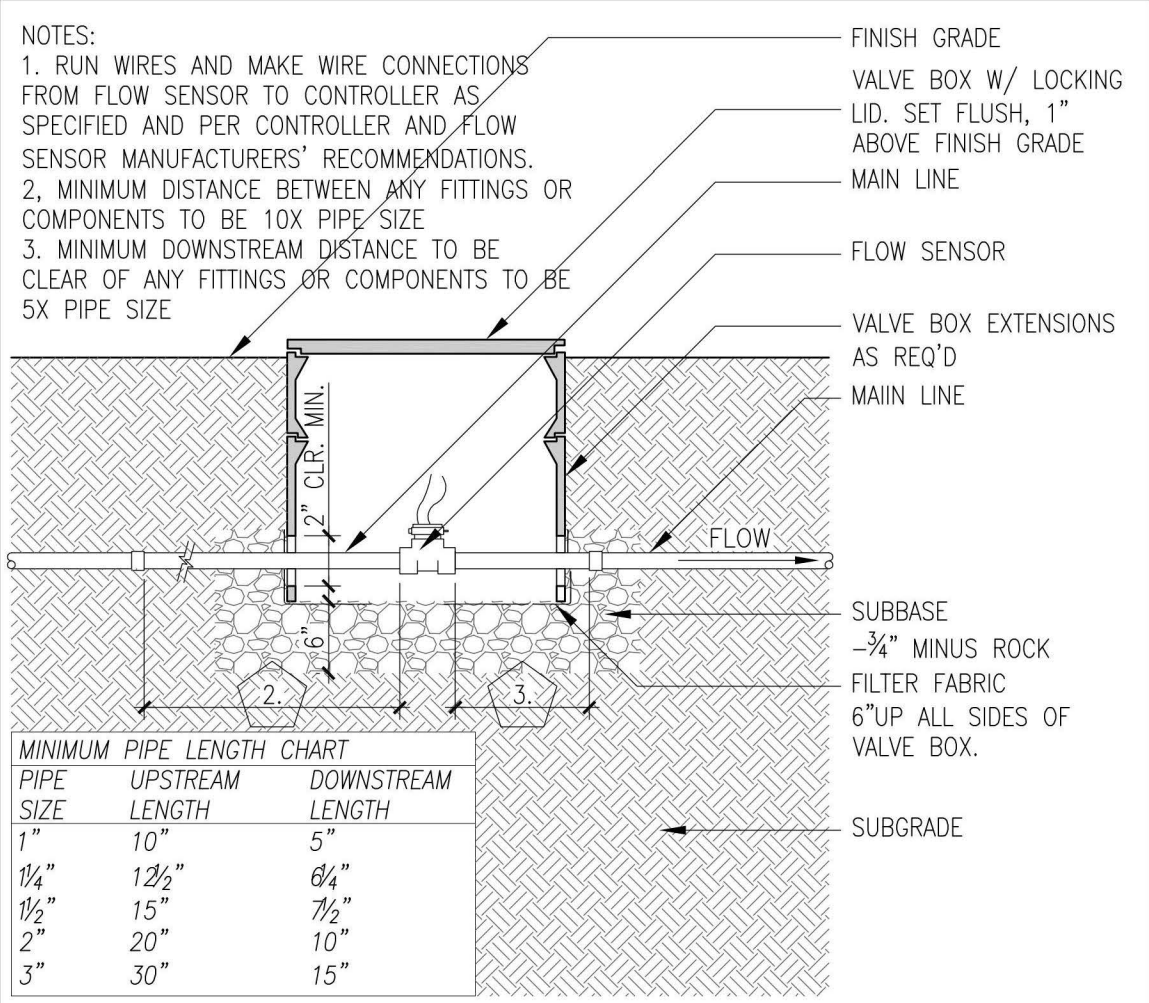


10

DETAIL: FLOW SENSOR

CAD FILE: IRR_VALVE-FLOWSENSOR.DWG

SCALE: 3/4" = 1'-0"

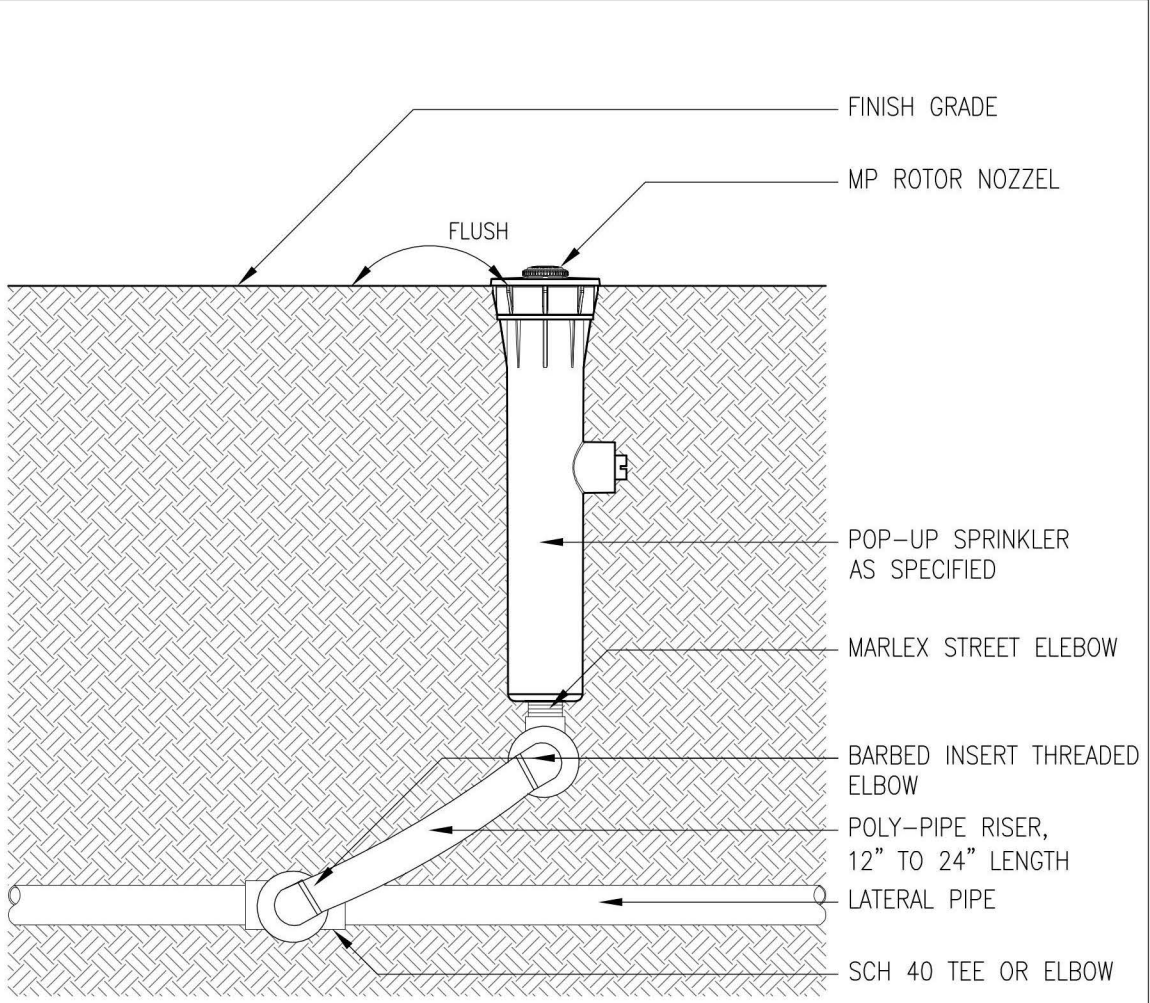


11

DETAIL: POP-UP SPRINKLER

CAD FILE: D_IRR-HEAD-POPUP_01.DWG

SCALE: N.T.S.

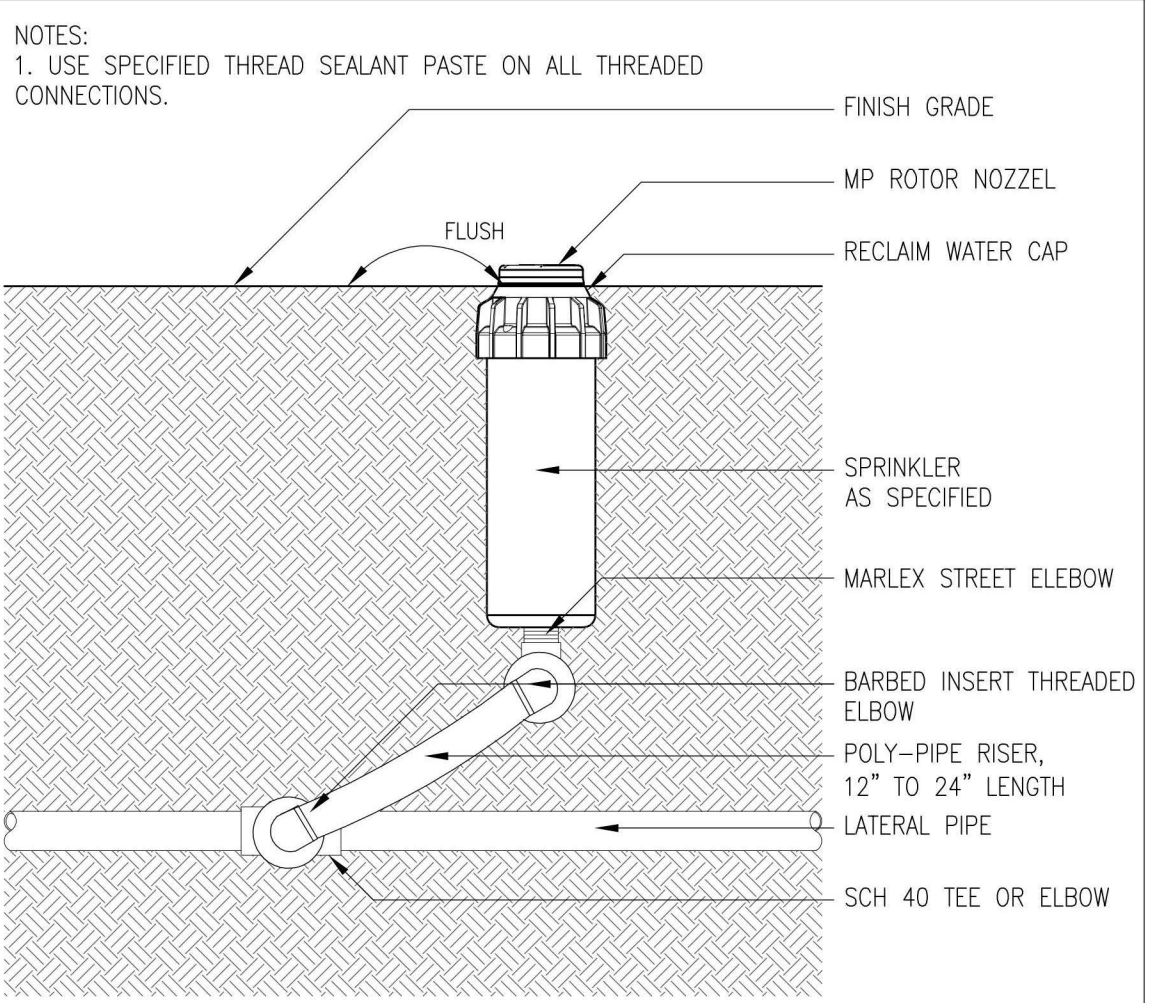









12

DETAIL: POP-UP ROTARY SPRINKLER

CAD FILE: D_IRRI-HEAD-ROTOR_01.DWG

SCALE: N.T.S.


REVISIONS		
DATE	DESCRIPTION	BY

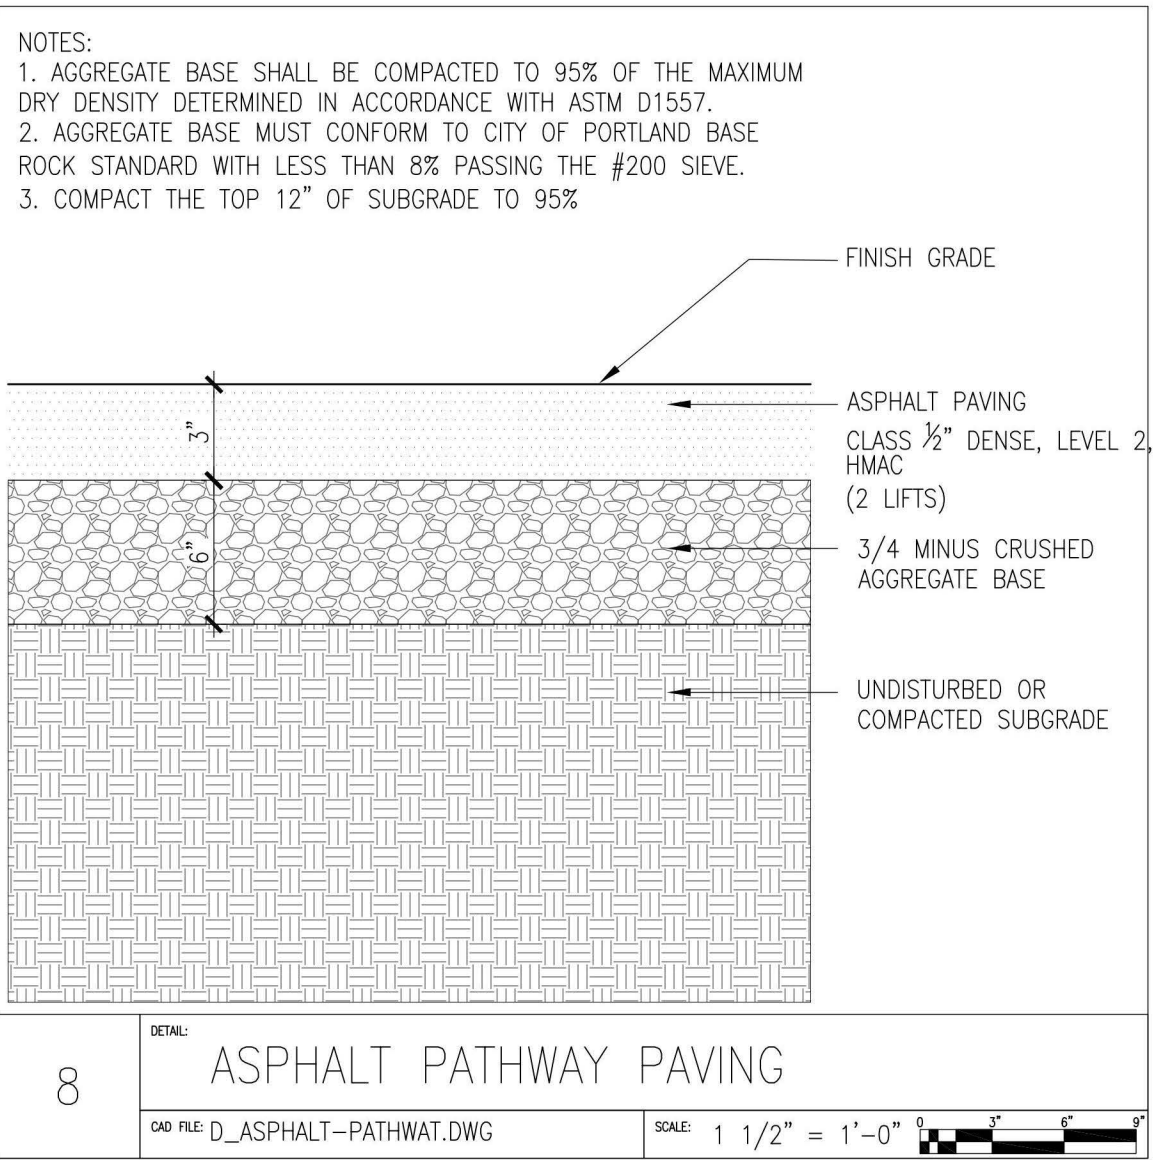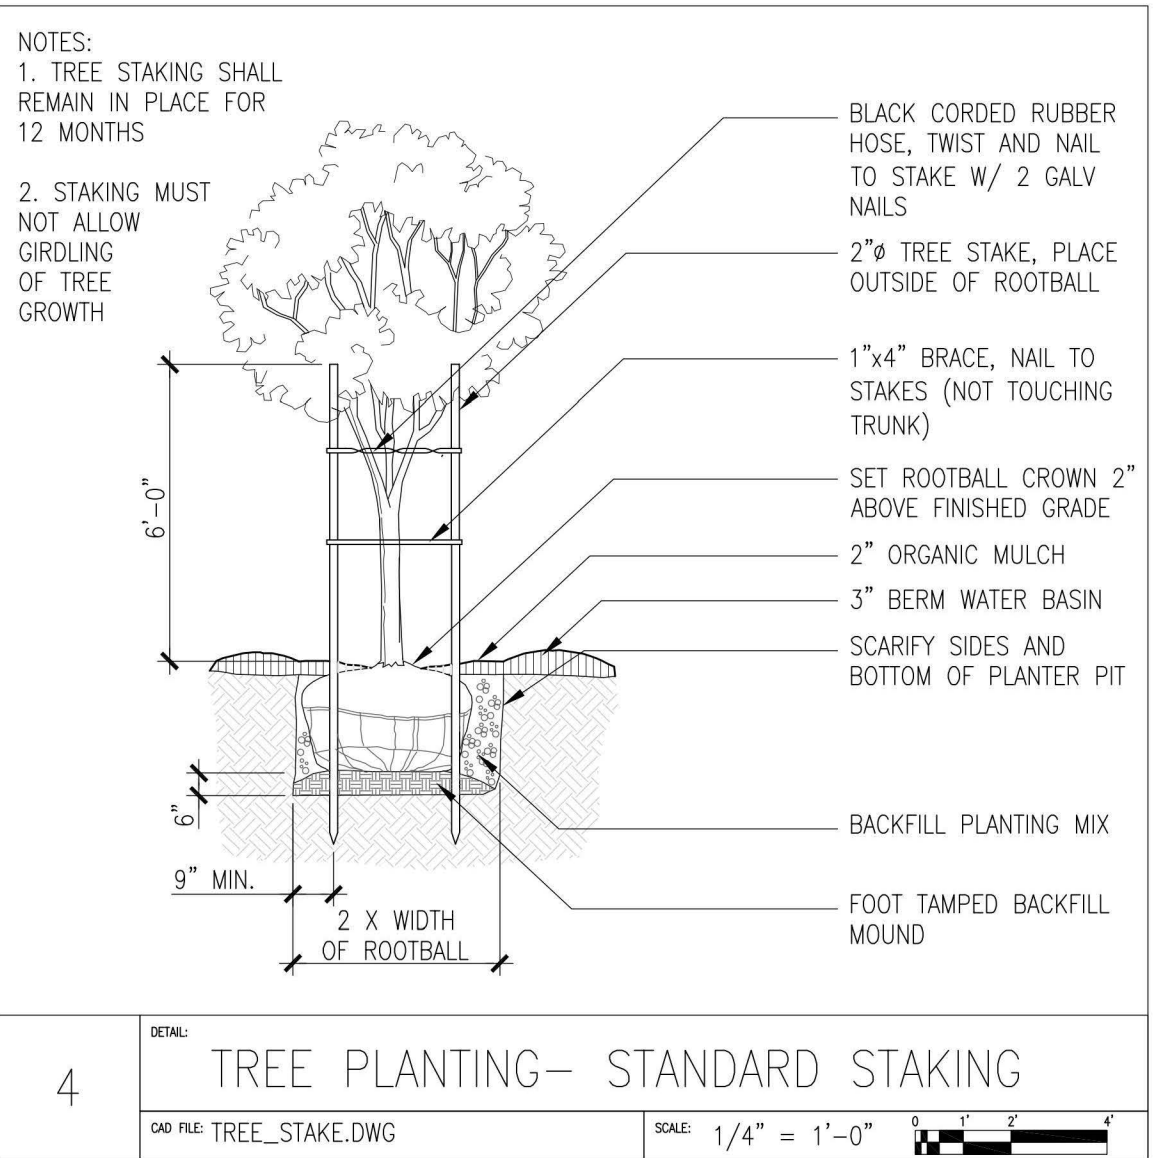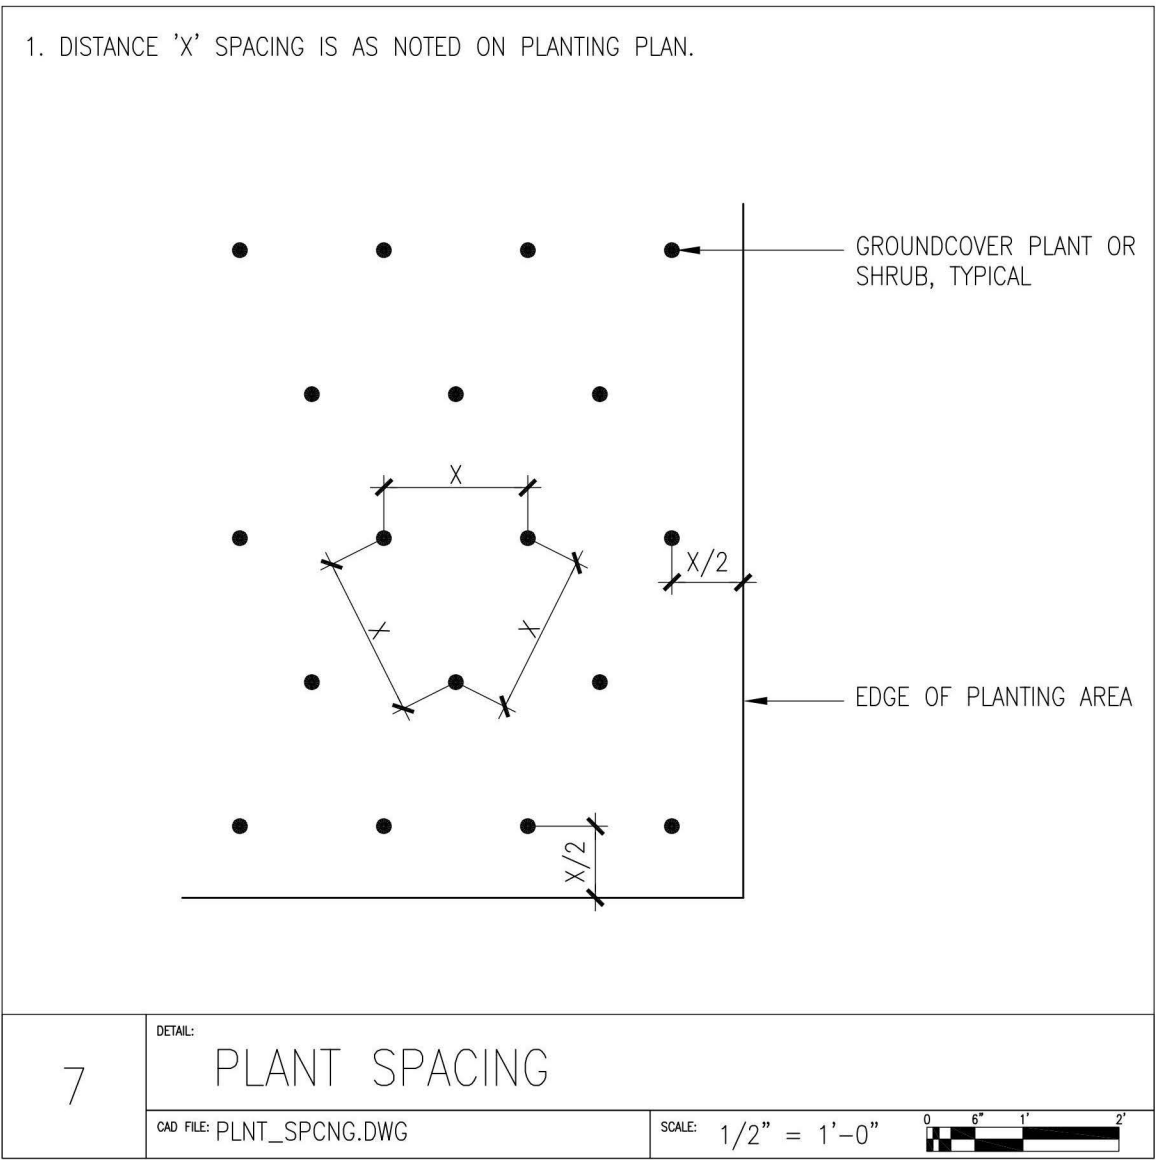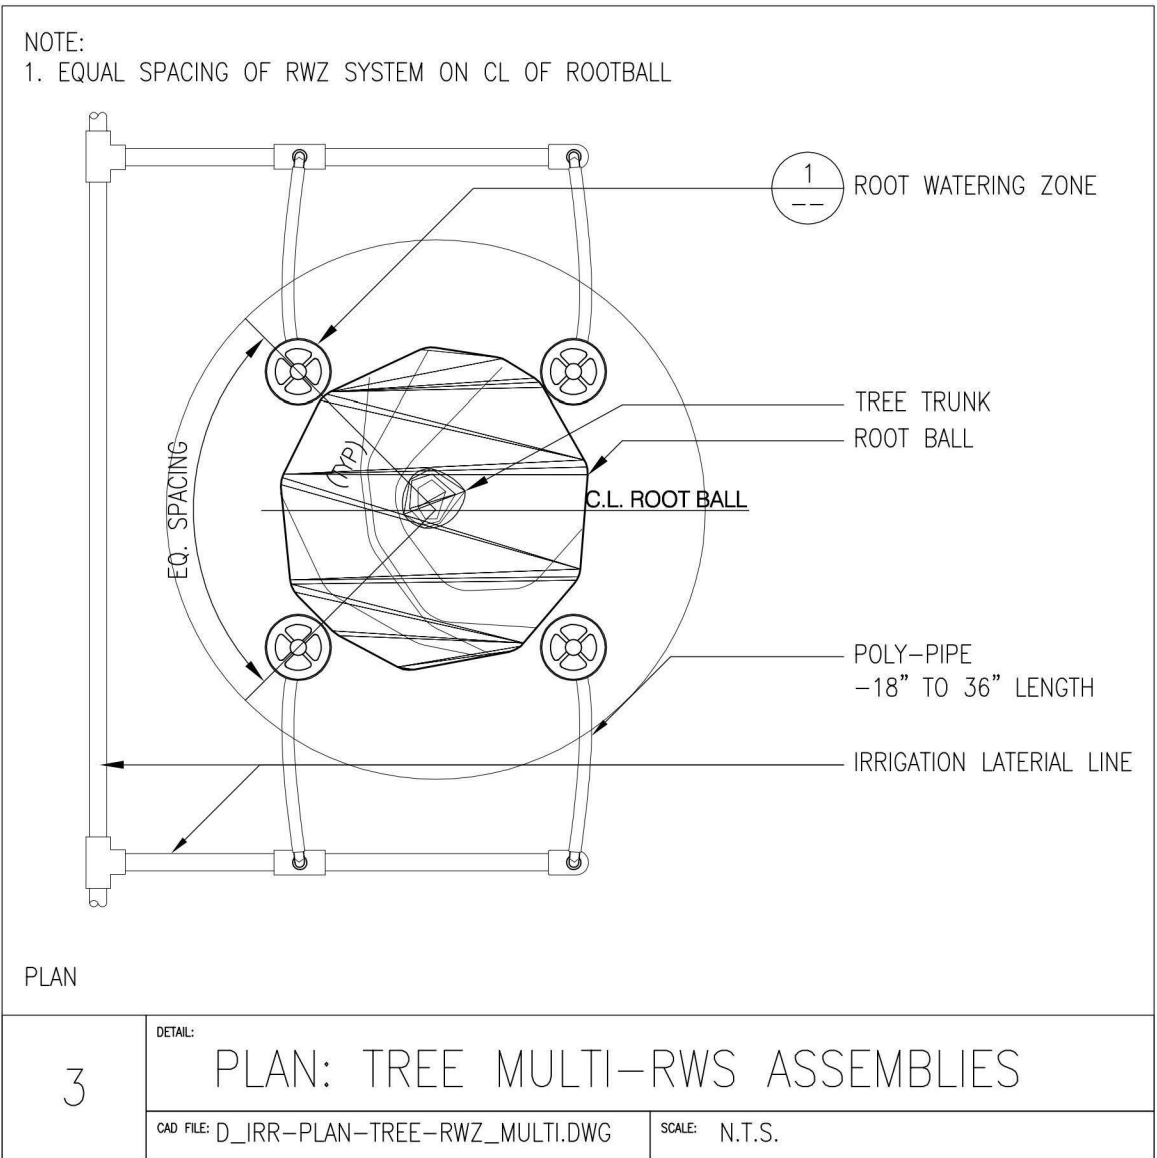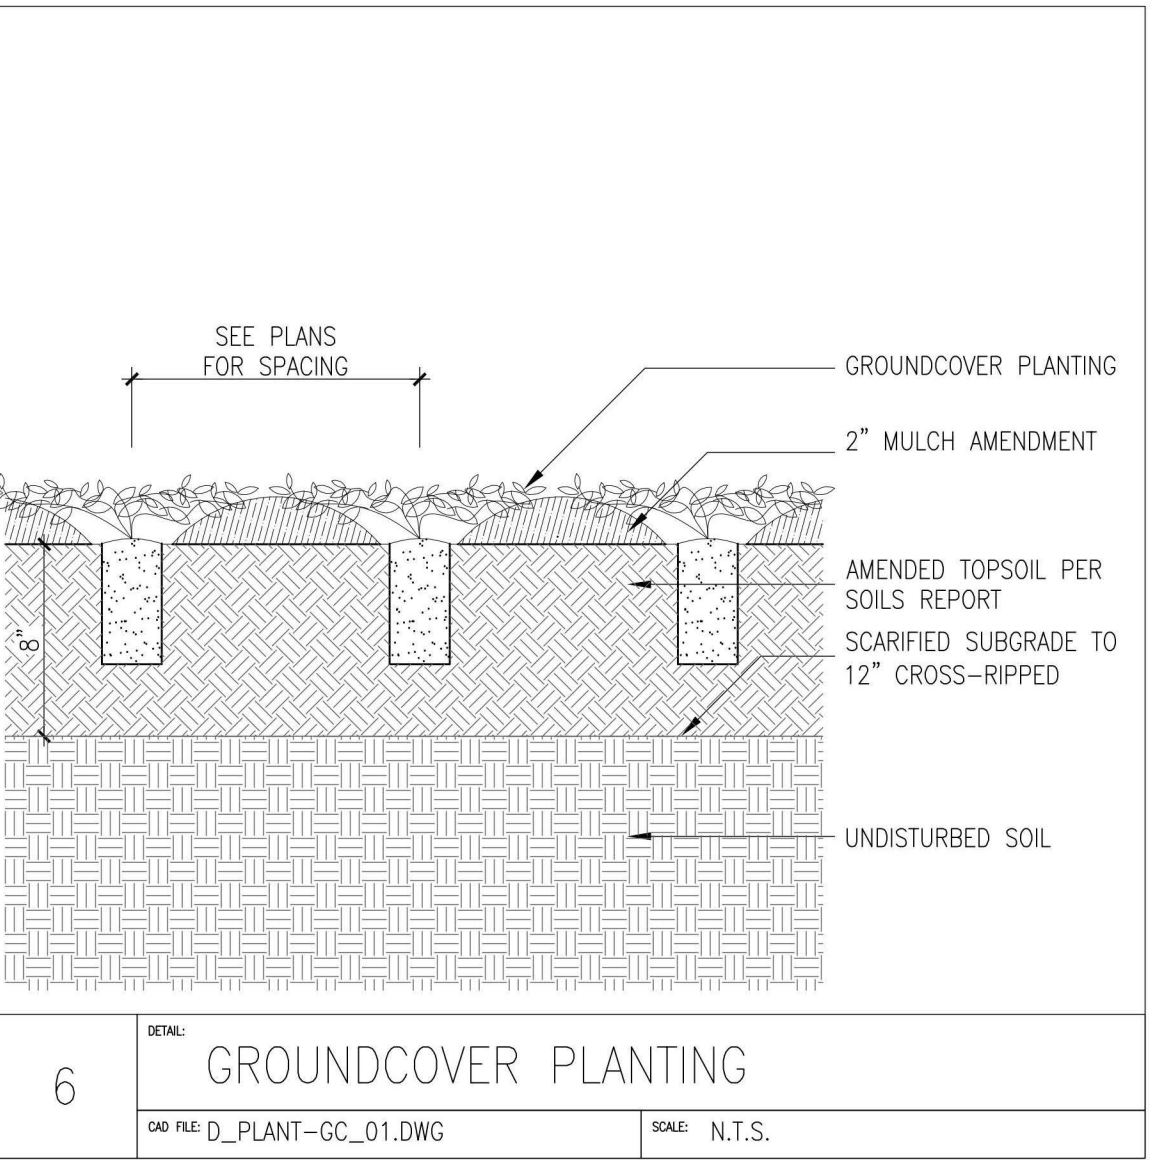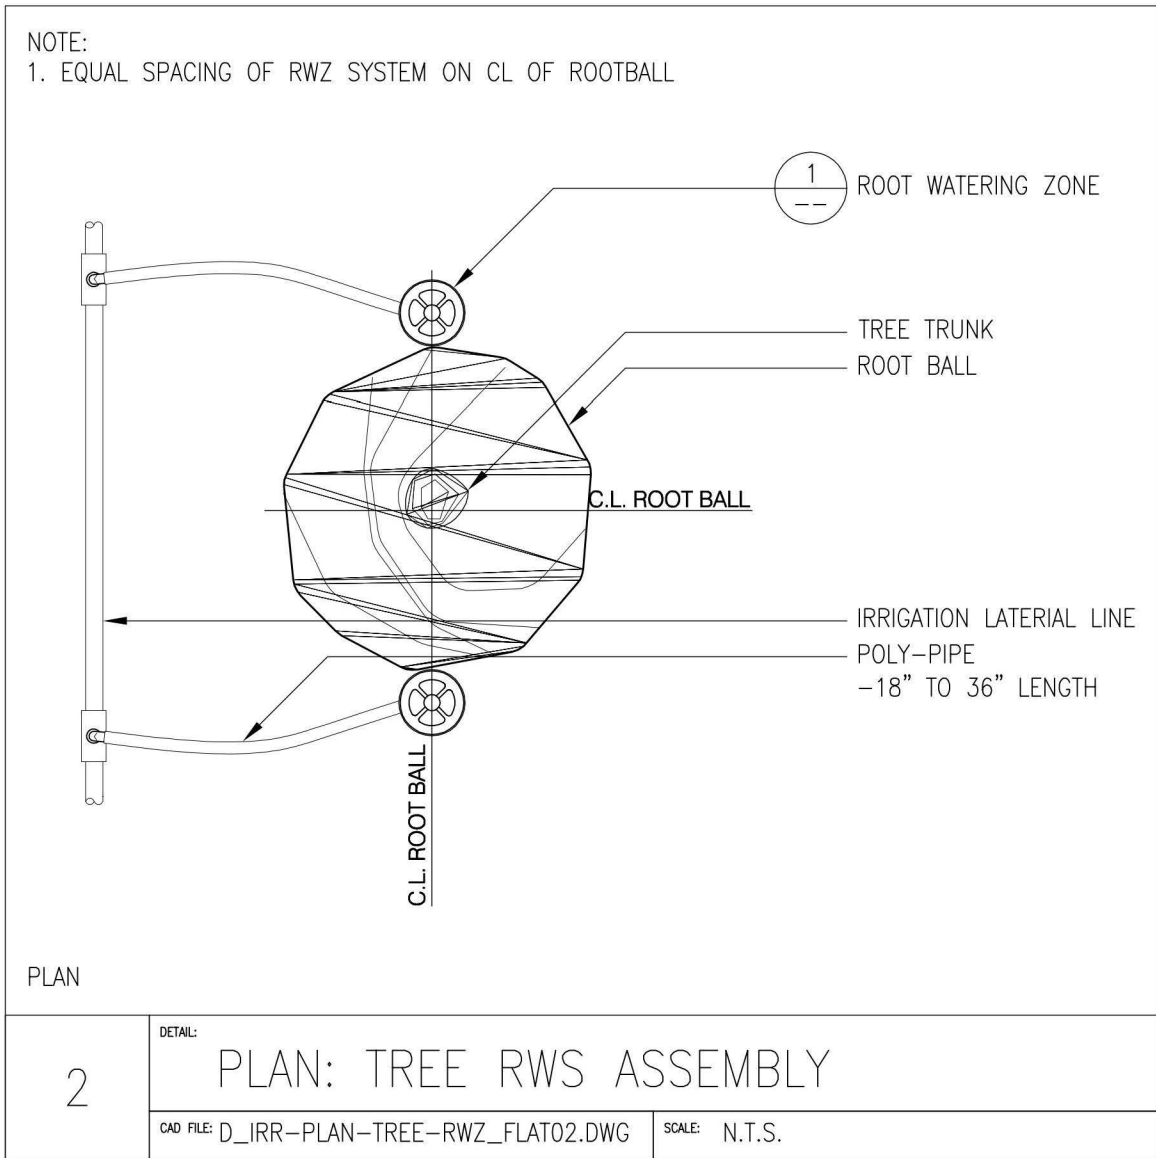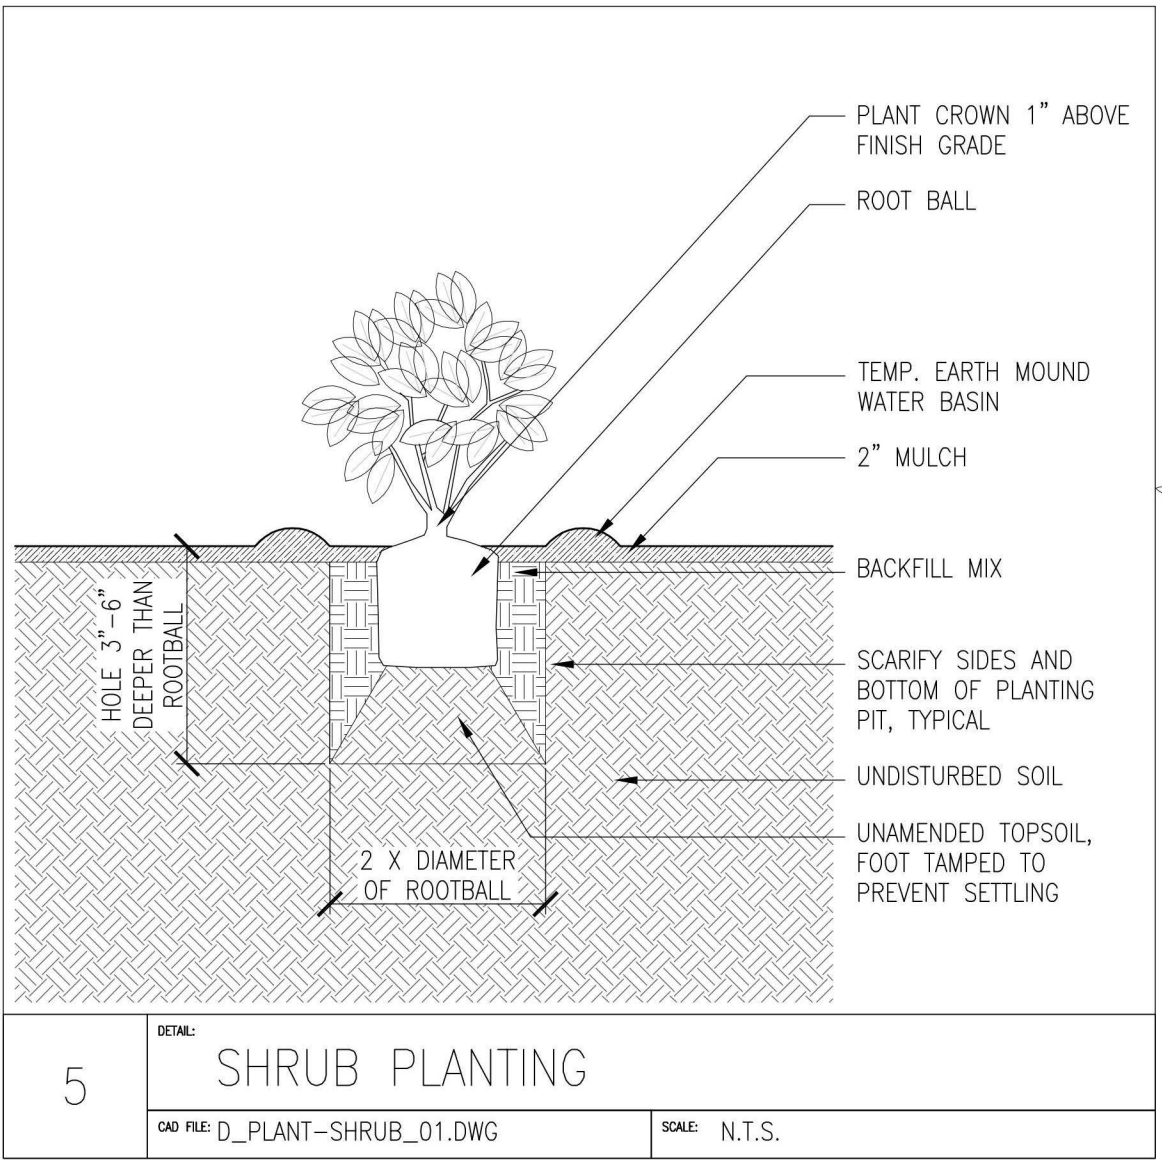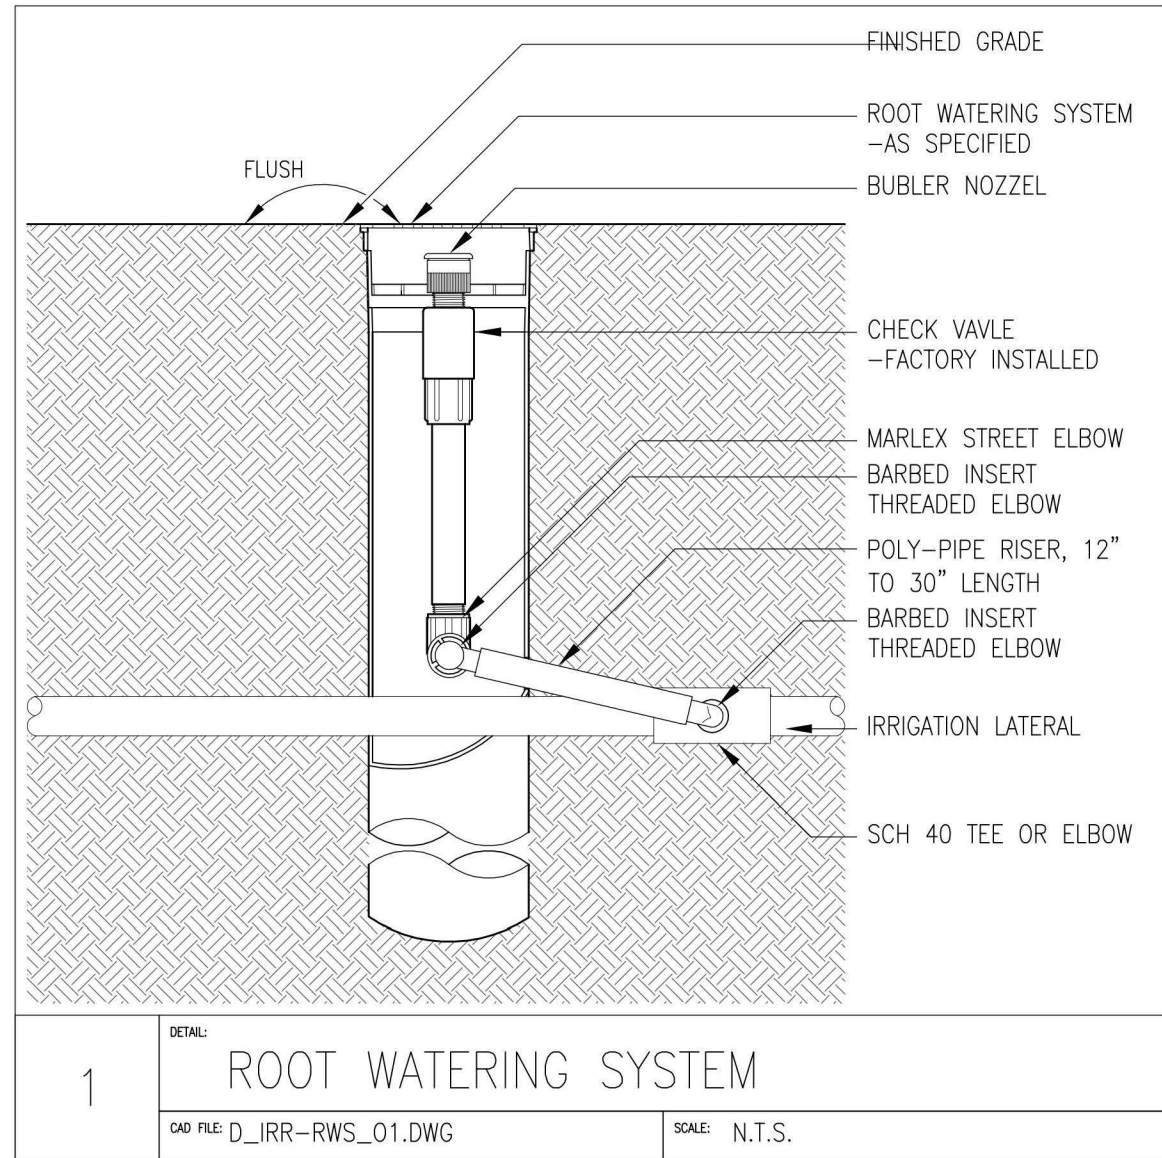

REVISIONS		
DATE	DESCRIPTION	BY



DRAWING: \$FILE\$ PLOTTED ON: \$DATE\$ PLOTTED BY: \$USERNAME\$ PLOTTED FROM: \$COMPUTERNAME\$

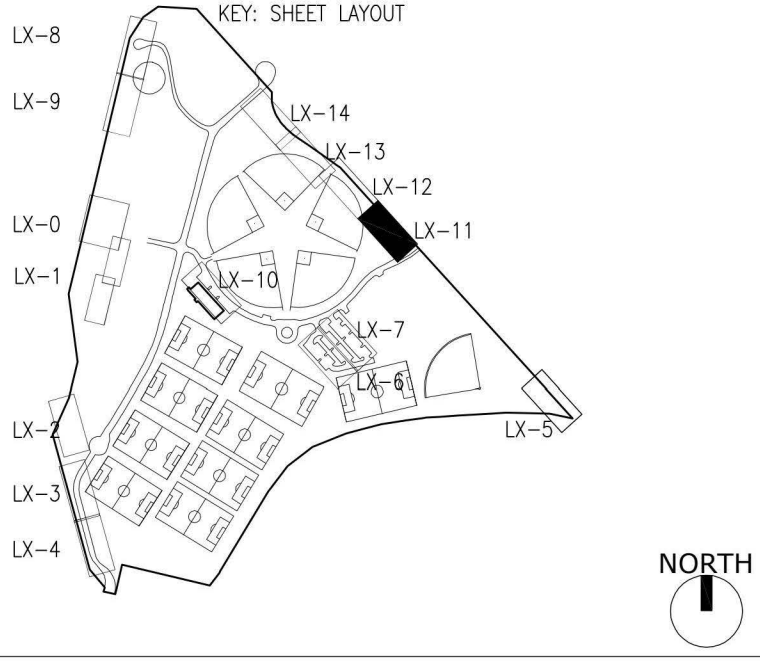

MATERIALS LEGEND:


EXISTING ASPHALT PAVING


**PORTLAND
PARKS & RECREATION**
Healthy Parks, Healthy Portland

opsis

503.525.9511
www.opsisarch.com
920 NORTHWEST SEVENTEENTH AVENUE
PORTLAND | OREGON | 97209
copyright 2016 opsis architecture llp
ALL RIGHTS RESERVED

PERMIT / BID SET
08.30.2018

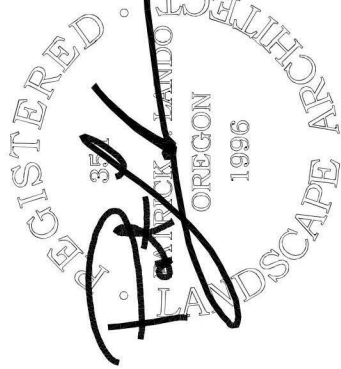

Portland Parks and Recreation

Ananda Fritz, Commissioner Kira Selley, Intern Director

Landscape As-Built Plans
Urban Forestry Maintenance Facility

PROJECT MANAGER: ROBIN LAUGHLIN

DATE: 10.04.2019 SCALE: DRAWN BY: PL SECTION:


REVISIONS

DATE	DESCRIPTION	BY




L5.11

Job No.
4655-01

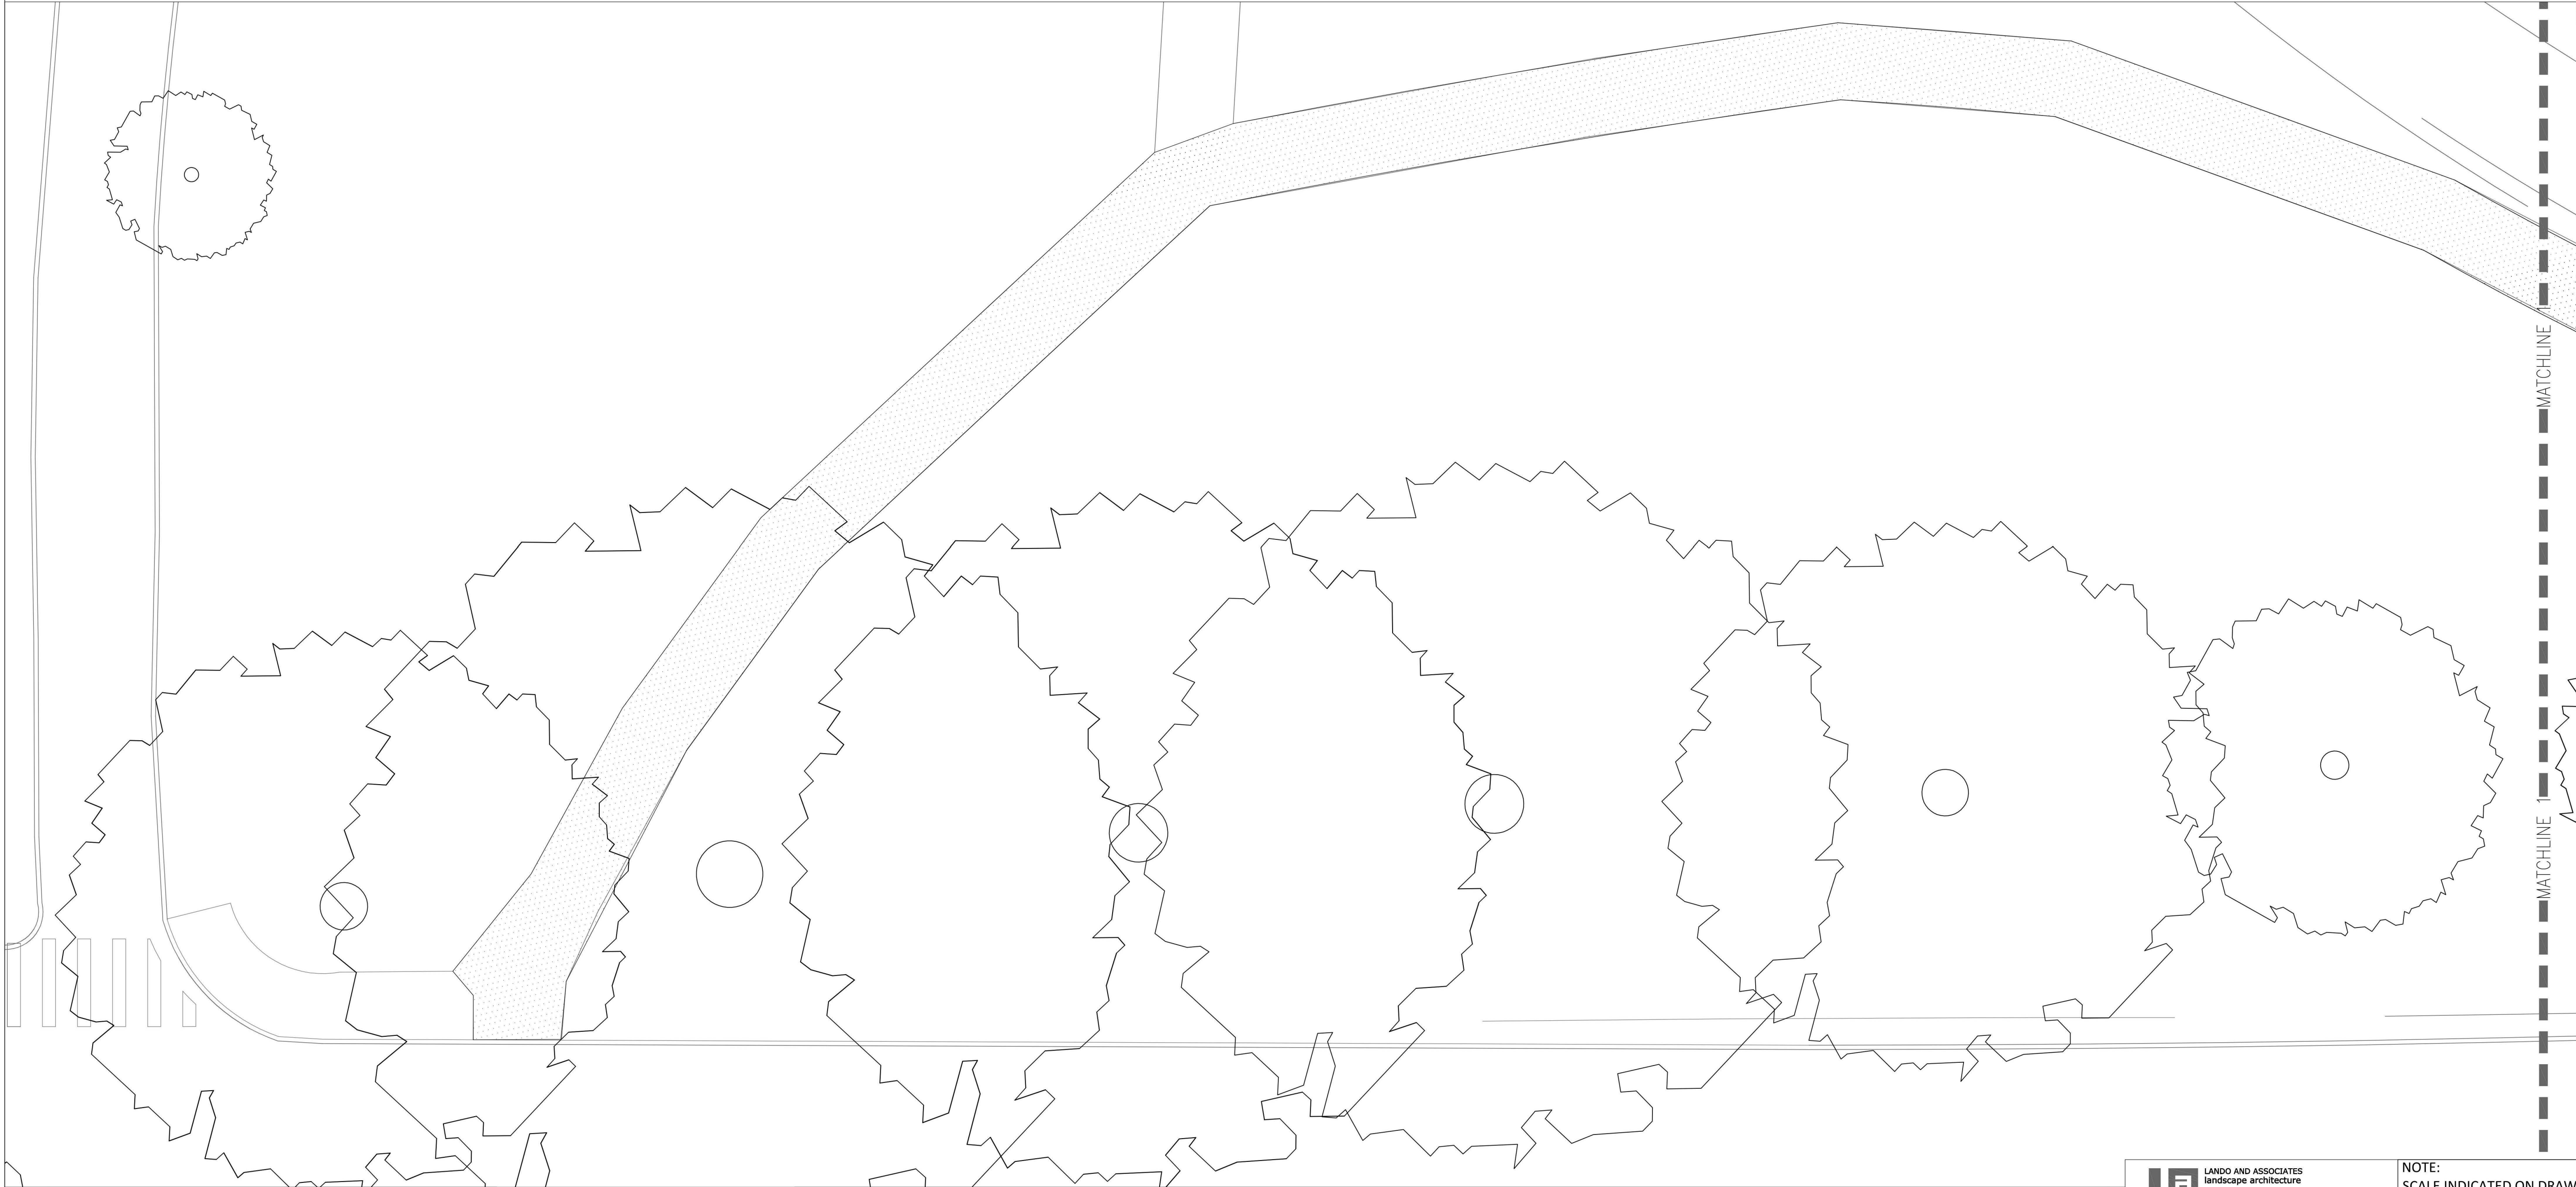

1 LANDSCAPE AS-BUILT PLAN

SCALE: 1" = 10' - 0"

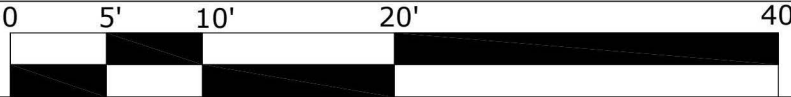


LANDO AND ASSOCIATES
landscape architecture
6607 SE SCOTT DRIVE
PORTLAND | OREGON | 97215
503.231.6600 | Lando_LandscapeArchitecture.com


NOTE:
SCALE INDICATED ON DRAWING
IS CORRECT IF DRAWING
BORDER IS 22" X 34".

PLOTTED FROM: \$COMPUTERNAME\$

PLOTTED BY: \$USERNAME\$


PLOTTED ON: \$DATE\$

DRAWING: \$FILE\$

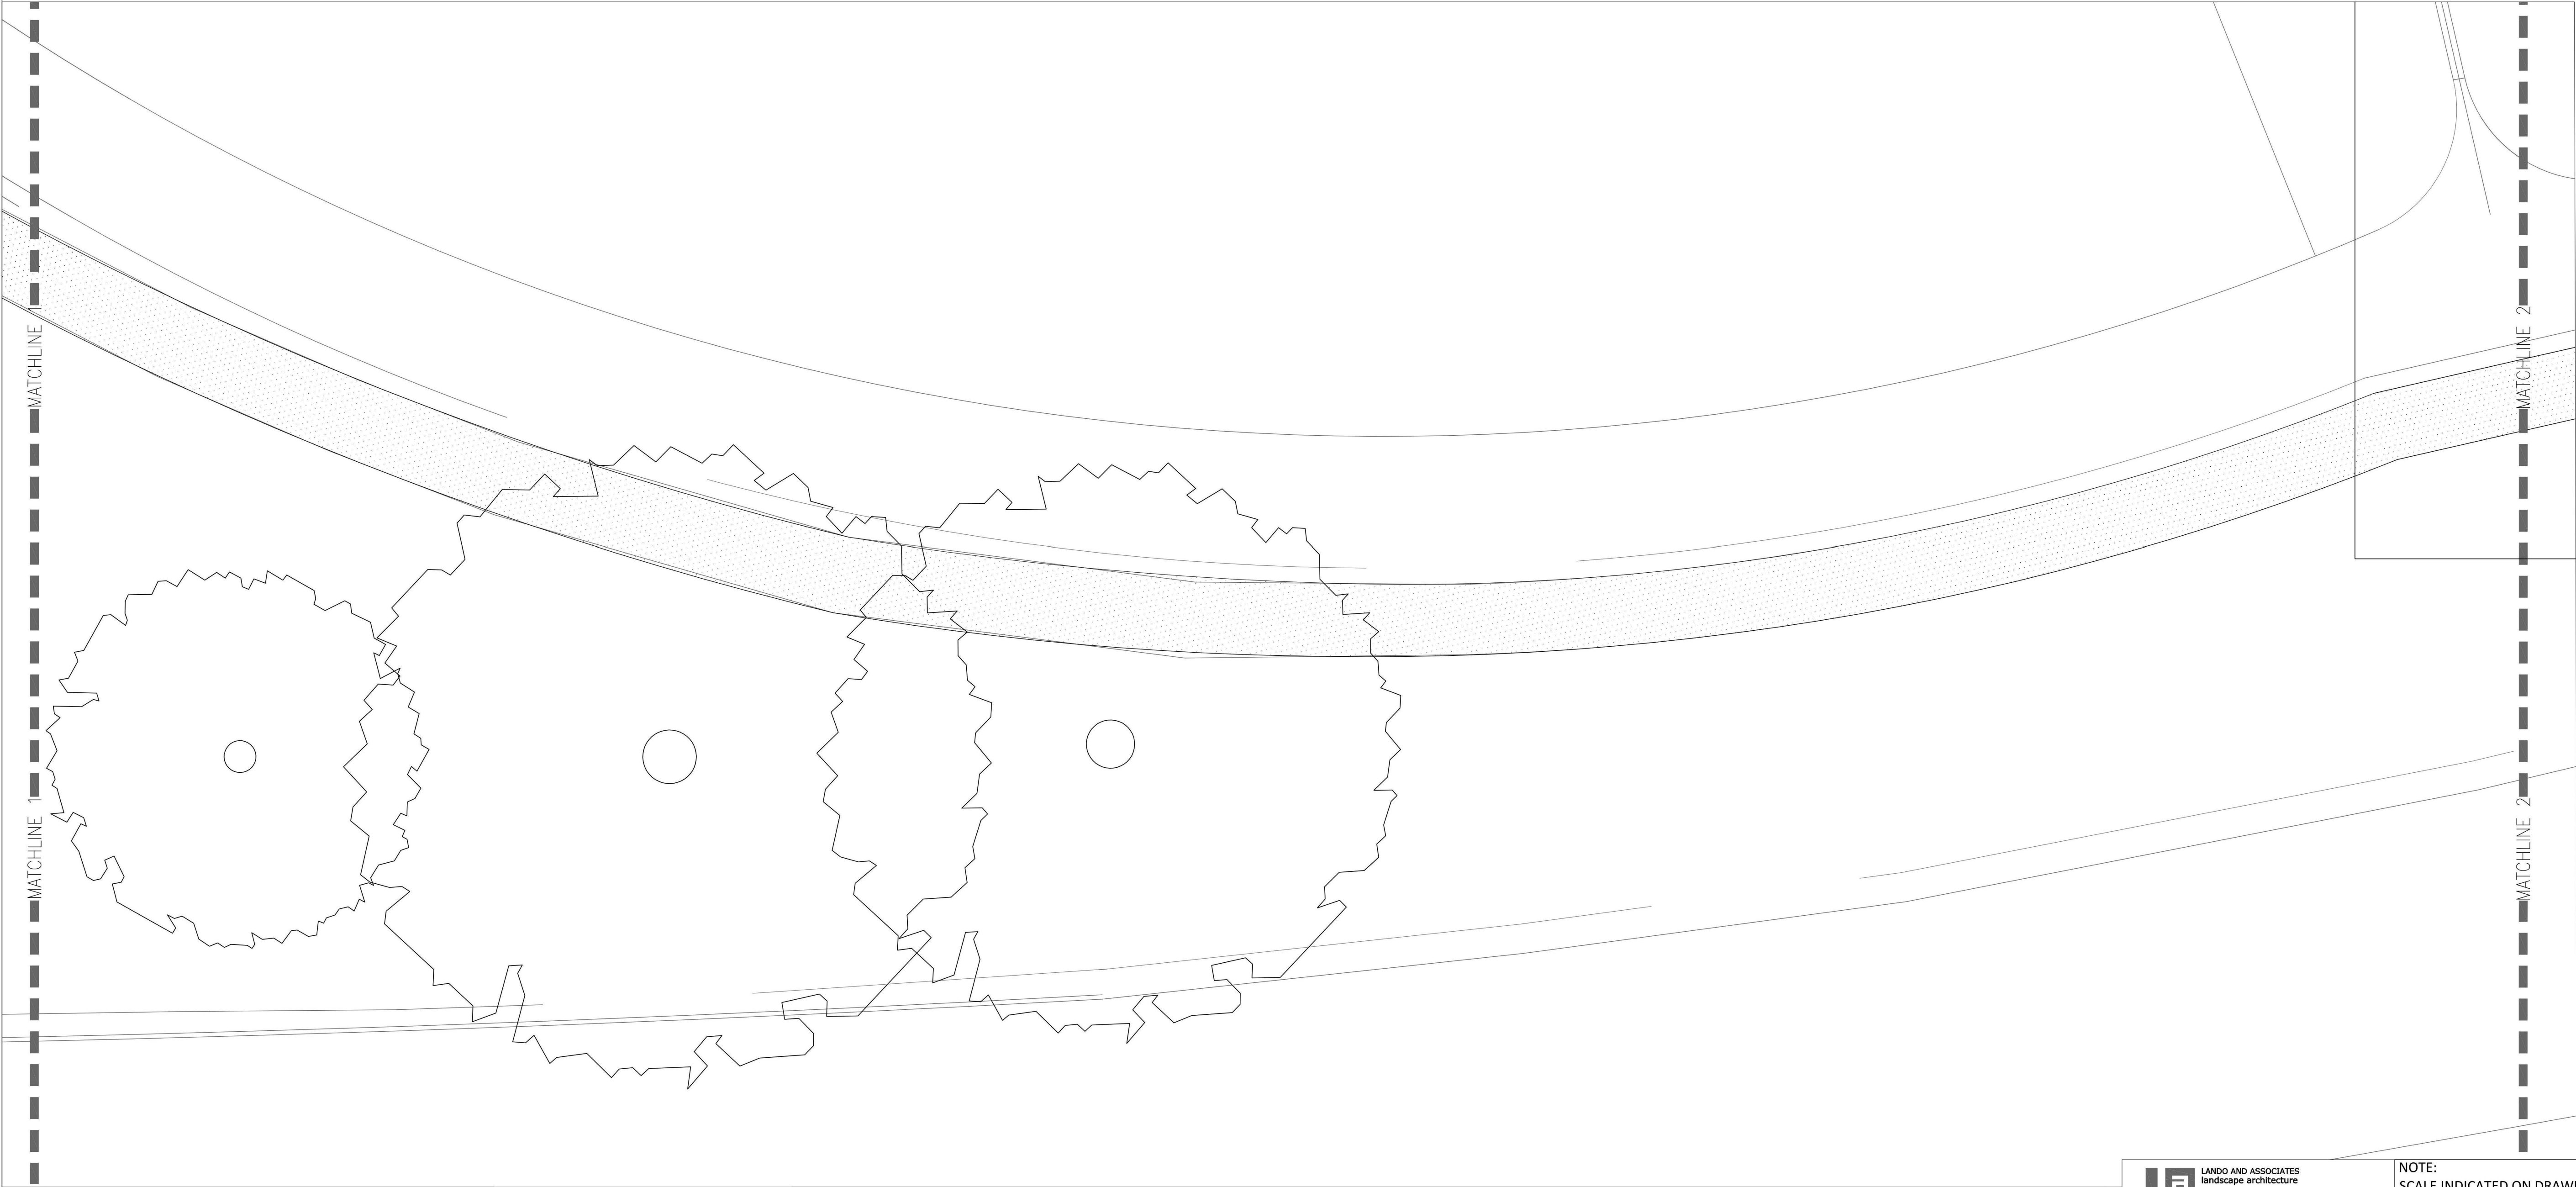

1 LANDSCAPE AS-BUILT PLAN

SCALE: 1" = 10' - 0"

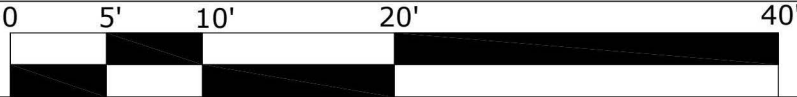


LANDO AND ASSOCIATES
landscape architecture
6607 SE SCOTT DRIVE
PORTLAND | OREGON | 97215
503.231.6600 | Lando_LandscapeArchitecture.com

NOTE:
SCALE INDICATED ON DRAWING
IS CORRECT IF DRAWING
BORDER IS 22" X 34".

MATERIALS LEGEND:

 EXISTING ASPHALT PAVING

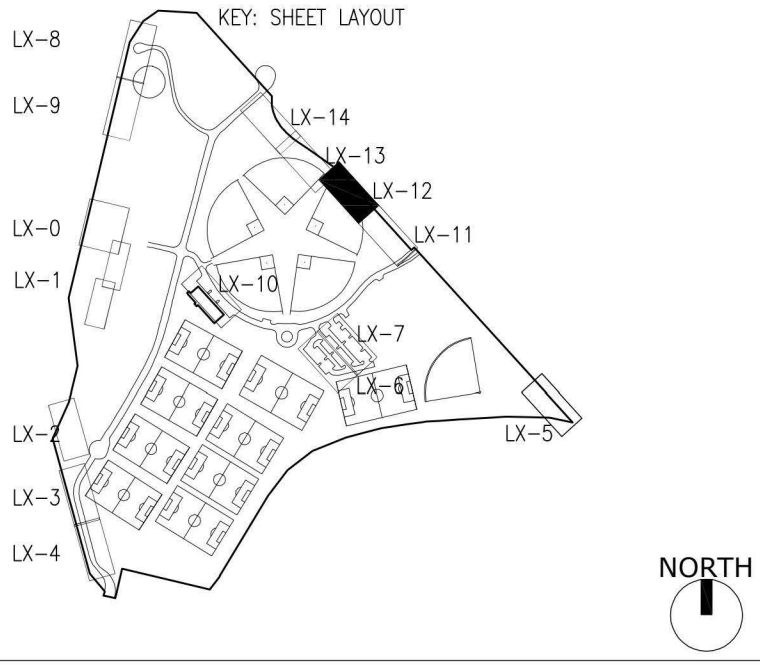



**PORTLAND
PARKS & RECREATION**
Healthy Parks, Healthy Portland

opsis

503.525.9511
www.opsisarch.com
920 NORTHWEST SEVENTEENTH AVENUE
PORTLAND | OREGON | 97209
copyright 2016 opsis architecture llp
ALL RIGHTS RESERVED

PERMIT / BID SET
08.30.2018

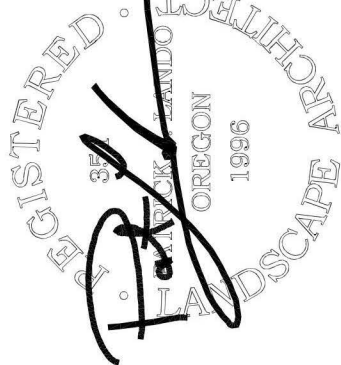

Portland Parks and Recreation

Ananda Fritz, Commissioner Kira Selley, Intern Director

Landscape As-Built Plans
Urban Forestry Maintenance Facility

10910 N Denver, Portland, OR 97217
PROJECT MANAGER: ROBIN LAUGHLIN

DATE: **10.04.2019**

SCALE:

DRAWN BY: **PL**

SECTION:

REVISIONS


DATE	DESCRIPTION	BY



L5.12


Job No.
4655-01

DRAWING: \$FILE\$ PLOTTED ON: \$DATE\$ PLOTTED BY: \$USERNAME\$ PLOTTED FROM: \$COMPUTERNAME\$

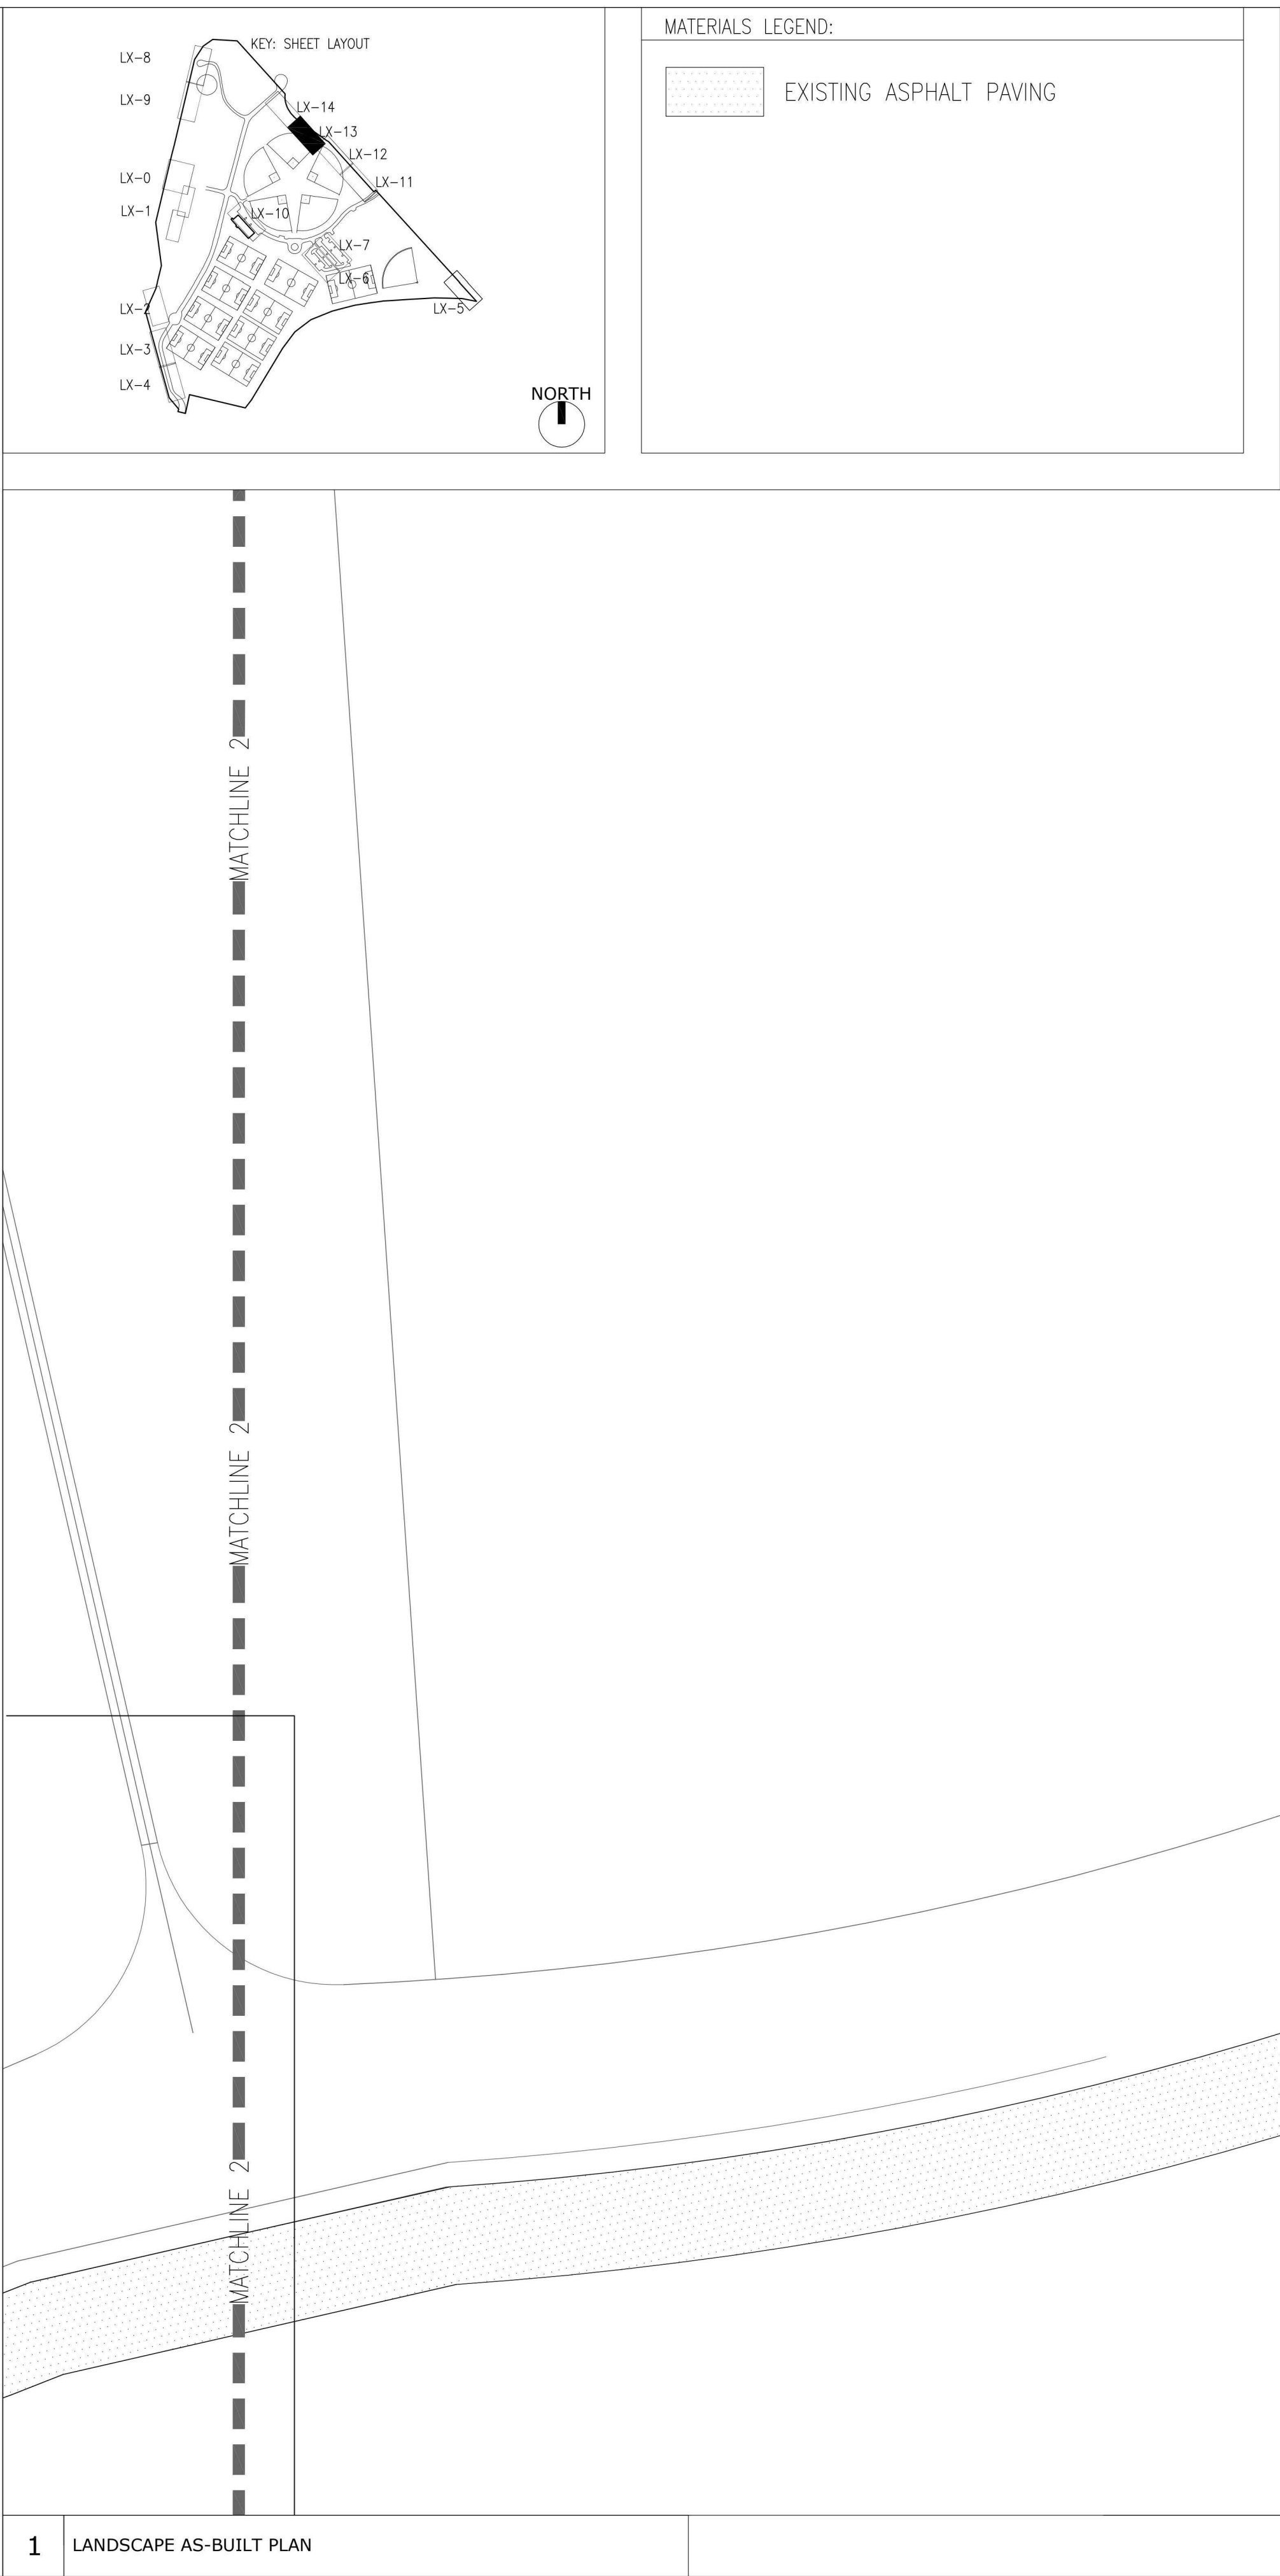

1	LANDSCAPE AS-BUILT PLAN
---	-------------------------

SCALE: 1" = 10' - 0"

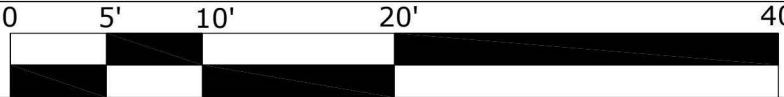

LANDO AND ASSOCIATES
landscape architecture
6607 SE SCOTT DRIVE
PORTLAND | OREGON | 97215
503.233.6600 | Lando_LandscapeArchitecture.com

NOTE:
SCALE INDICATED ON DRAWING
IS CORRECT IF DRAWING
BORDER IS 22" X 34".

**PORTLAND
PARKS & RECREATION**
Healthy Parks, Healthy Portland

503.525.9511
www.opsisarch.com
920 NORTHWEST SEVENTEENTH AVENUE
PORTLAND | OREGON | 97209
copyright 2016 opsis architecture llp
ALL RIGHTS RESERVED

PERMIT / BID SET
08.30.2018

Portland Parks and Recreation
Ananda Fritz, Commissioner Kira Selley, Intern Director

Landscape As-Built Plans
Urban Forestry Maintenance Facility
PROJECT MANAGER: ROBIN LAUGHLIN



DATE: **10.04.2019** SCALE: DRAWN BY: **PL** SECTION:


REVISIONS		
DATE	DESCRIPTION	BY

**PARKS
REPLACEMENT
BOND
2014**

L5.13

Job No. **4655-01**

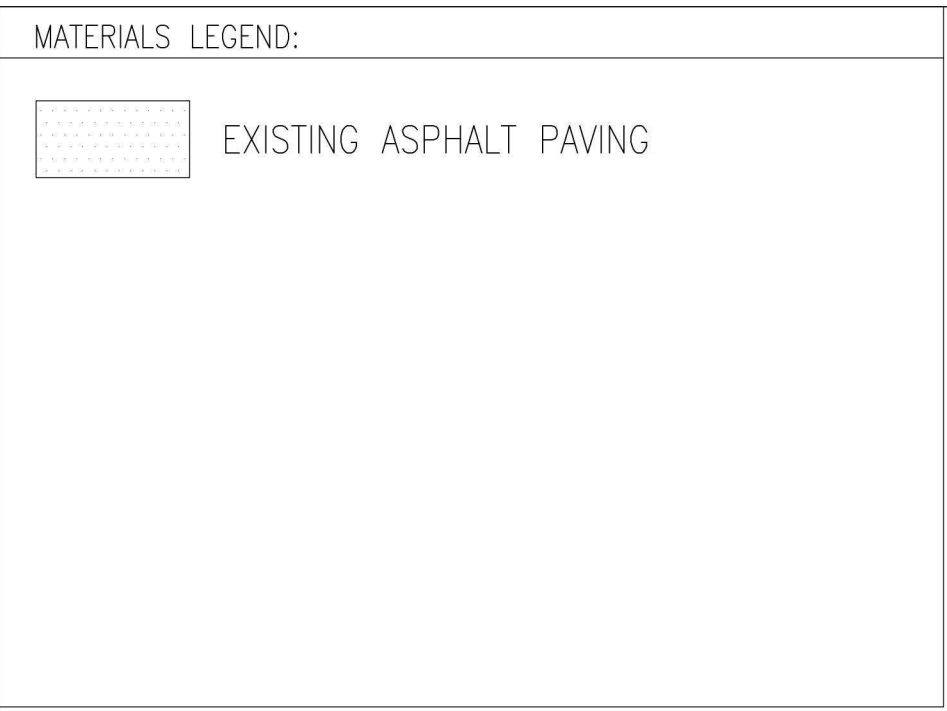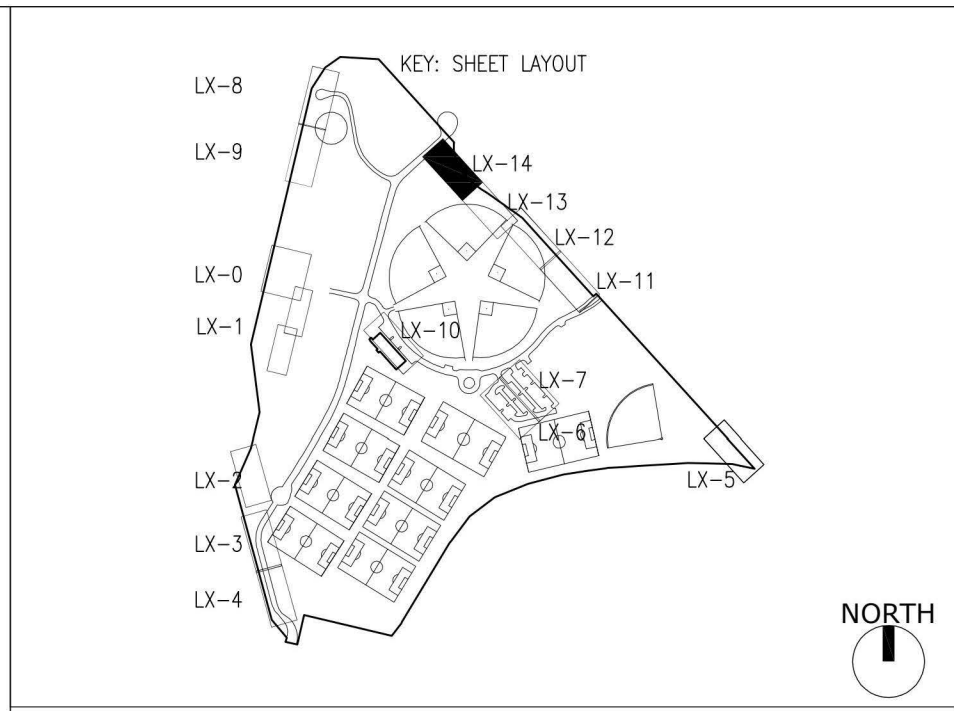

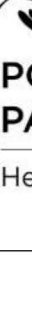 PORTLAND PARKS & RECREATION Healthy Parks, Healthy Portland																				
 503.525.9511 www.opsisarch.com 920 NORTHWEST SEVENTEENTH AVENUE PORTLAND OREGON 97209 copyright 2016 opsis architecture llp ALL RIGHTS RESERVED																				
PERMIT / BID SET 08.30.2018 																				
Portland Parks and Recreation Ananda Fritz, Commissioner Kira Selley, Interm Director Landscape As-Built Plans Urban Forestry Maintenance Facility 10910 N Denver, Portland, OR 97217 PROJECT MANAGER: ROBIN LAUGHLIN																				
DATE: 10.04.2019 SCALE: DRAWN BY: PL SECTION:																				
REVISIONS <table border="1"> <thead> <tr> <th>DATE</th> <th>DESCRIPTION</th> <th>BY</th> </tr> </thead> <tbody> <tr><td> </td><td> </td><td> </td></tr> <tr><td> </td><td> </td><td> </td></tr> <tr><td> </td><td> </td><td> </td></tr> <tr><td> </td><td> </td><td> </td></tr> <tr><td> </td><td> </td><td> </td></tr> </tbody> </table>			DATE	DESCRIPTION	BY															
DATE	DESCRIPTION	BY																		
																				
L5.14 Job No. 4655-01																				